


T. 11 S. R. 6 W. W. M.

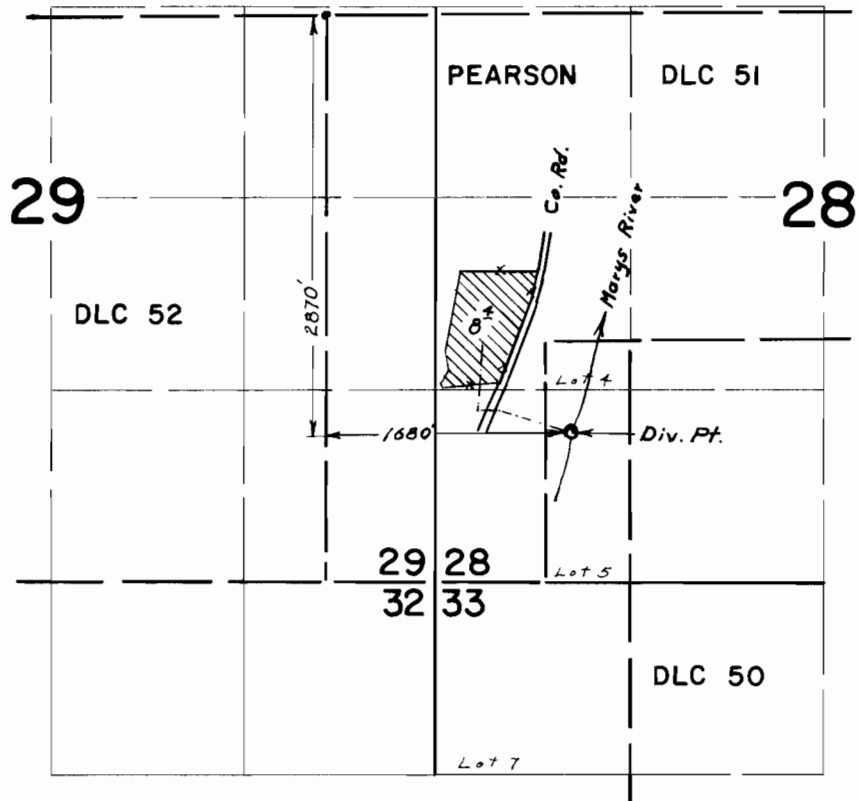

FINAL PROOF SURVEY
UNDER

Application No. 41984 Permit No. 31424
IN NAME OF

HAROLD JAMES JENSEN

Surveyed Nov. 10 1969, by L. E. Gould