


T.13S.R.6W.W.M.

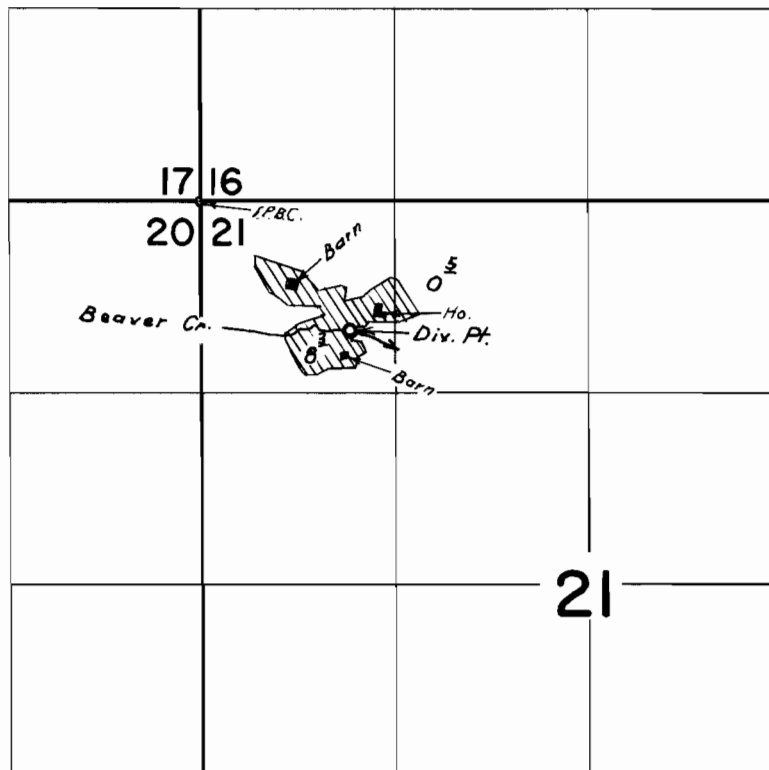

Div. Pt. located: 880 ft S. & 1020 ft E. from NW cor. Sec. 21

FINAL PROOF SURVEY
UNDER

Application No. 42252 Permit No. 31613
IN NAME OF

CLIFFORD MELBY

Surveyed Nov. 13, 1969, by L. E. Gould