


T.5S.R.3E.W.M.

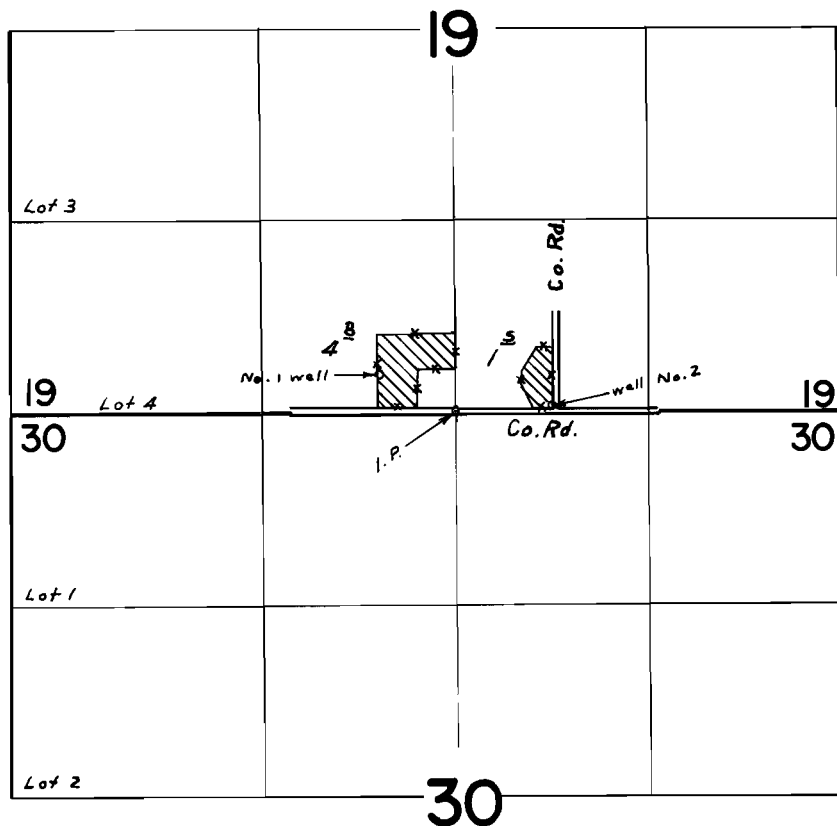

Wells located : 260 ft. N. & 3150 ft. W.; and 40 ft. N. & 1970 ft. W; both from SE cor. Sec. 19.

FINAL PROOF SURVEY
UNDER

Application No. G-3487... Permit No. G-3287...
IN NAME OF

EVERETT F. SMITH

Surveyed Nov. 24, 1969, by L. E. Gould