


T.29S.R.15W.W.M.

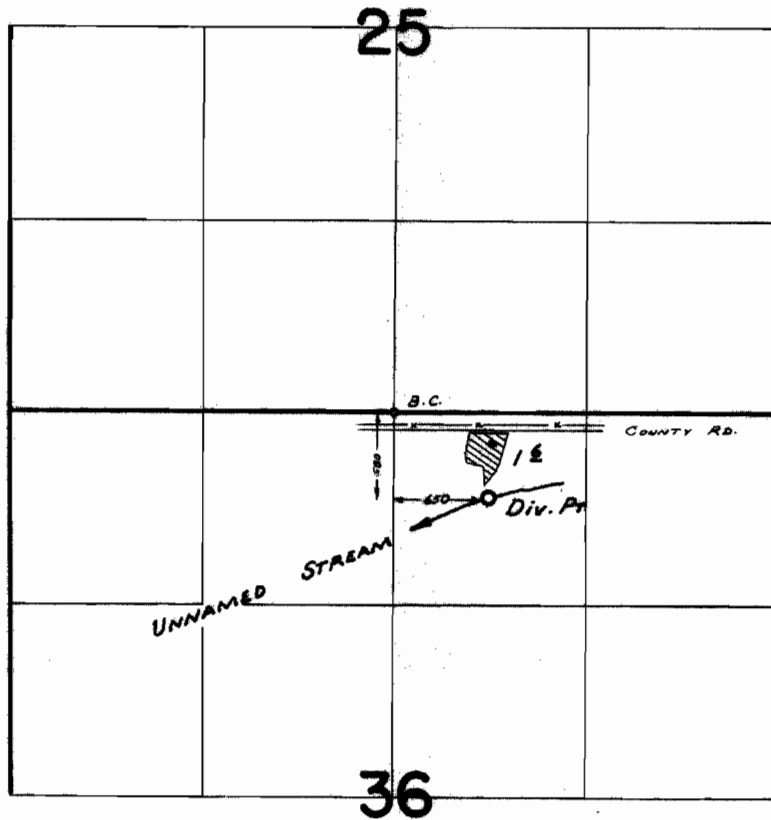

FINAL PROOF SURVEY
UNDER

Application No. 43796 Permit No. 32723
IN NAME OF

WALTER M. WILLIAMS

Surveyed MAY 12 1969, by W. RUPPERT