


T. 33 S. R. 14 W. W.M.

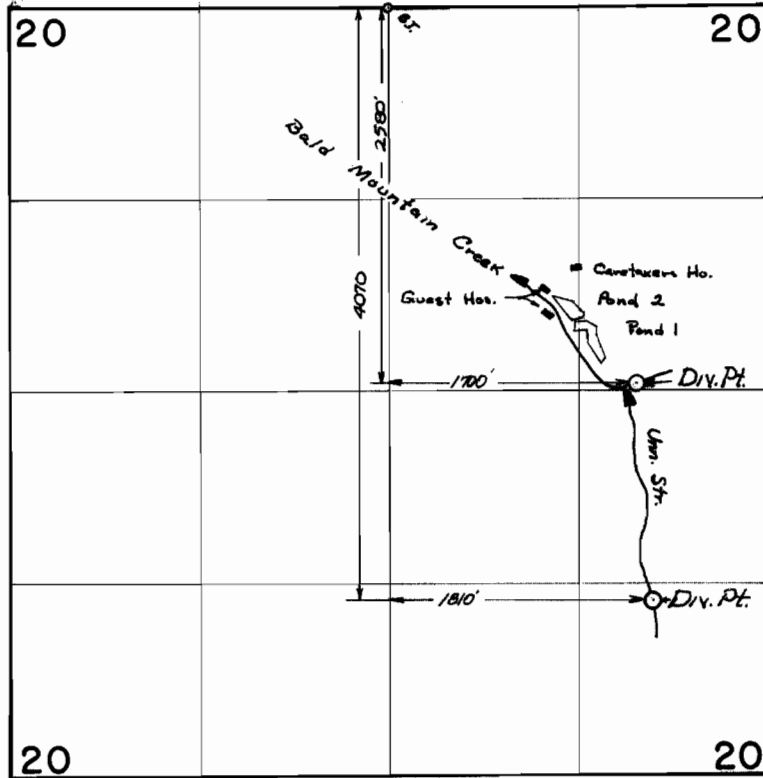

FINAL PROOF SURVEY
UNDER

R40244 R 4479
Application No. 39824 Permit No. 29894
IN NAME OF

.....**EARL & JEAN DAY**.....

Surveyed 8 SEPT. 1969, by L. E. GOULD.....