


T.40 & 41S.R.13W.W.M.

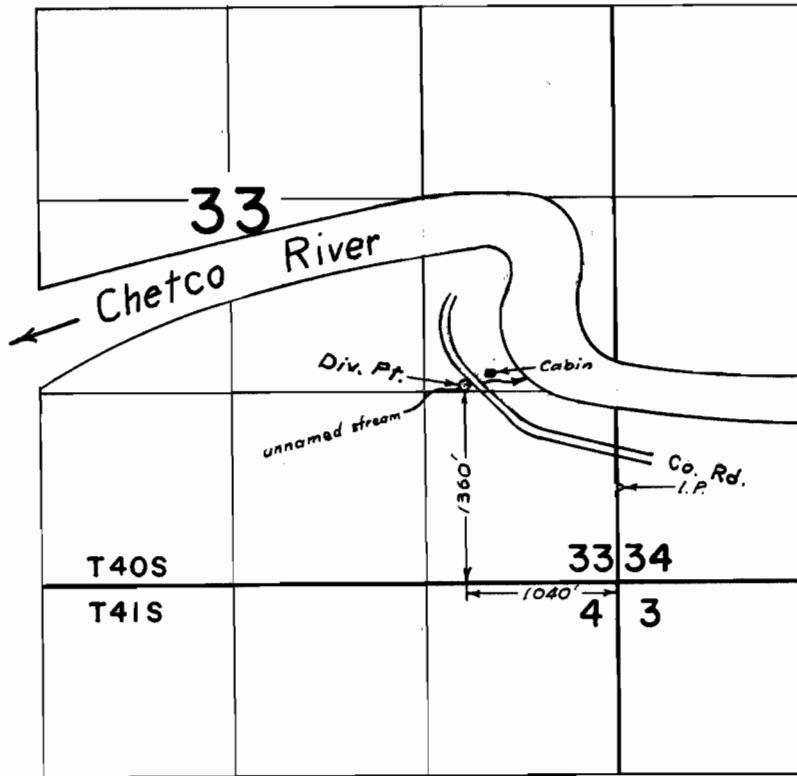

FINAL PROOF SURVEY UNDER

Application No. 38851 Permit No. 28943
IN NAME OF

CHARLES WICKS

Surveyed Aug. 23, 1969, by L. E. Gould