T.38S.R.14W.W.M.

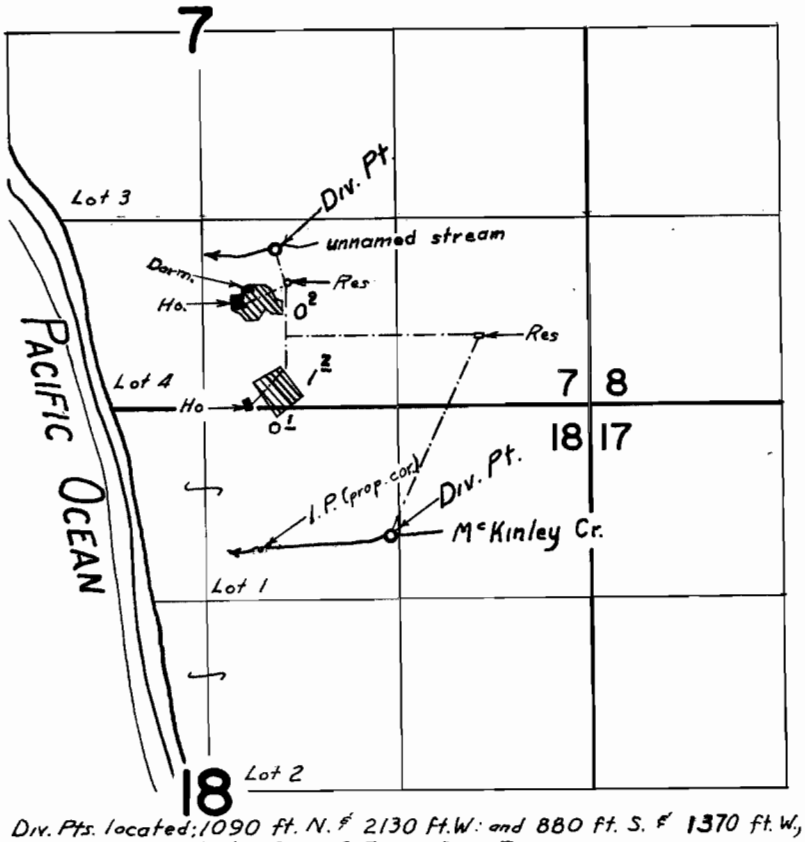

Div. Pts. located; 1090 ft. N. & 2130 ft. W. and 880 ft. S. & 1370 ft. W., both from S.E. cor. Sec. 7.

FINAL PROOF SURVEY
UNDER

Application No. 39304 42863 Permit No. 29272 32035

IN NAME OF

MAYTOR H. McKINLEY

Surveyed Aug. 26 1969, by L. E. Gould

1969-V
R.C.E.