


T.40 & 41S.R13W.W.M.

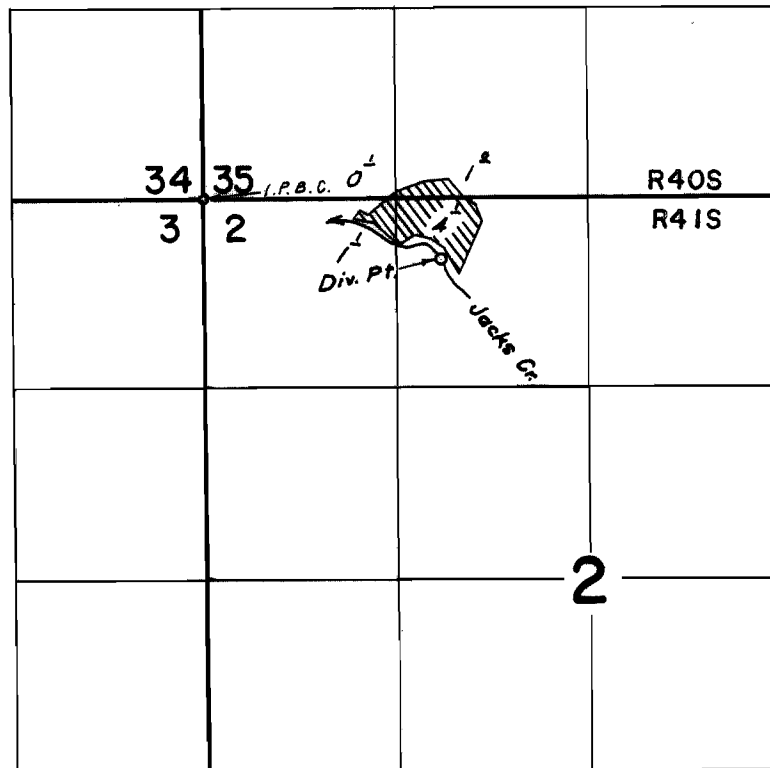

Div. Pt. located: 410 ft. S. & 1630 ft. E. from NW cor. Sec. 2.

FINAL PROOF SURVEY UNDER

Application No. 39660 Permit No. 29479
IN NAME OF

THEADORE L. FREEMAN

Surveyed Sept. 10, 1969, by L. E. Gould