


T.41S. R.13W.W.M.

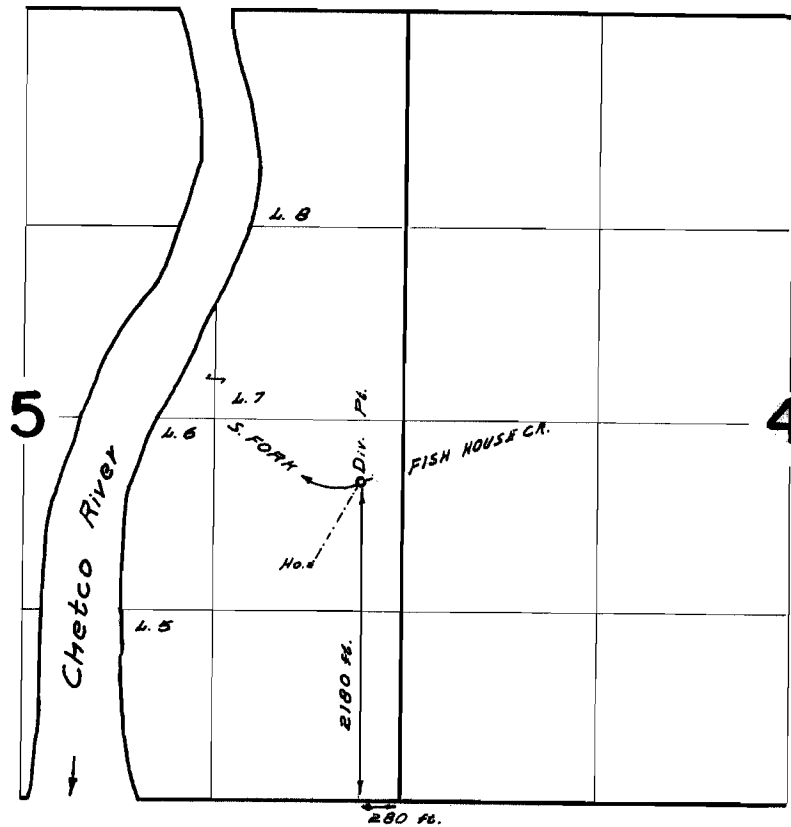

FINAL PROOF SURVEY
UNDER

Application No. 39723 Permit No. 29486
IN NAME OF

Jule E. & Donna E. Thompson

Surveyed Sept 13 1965, by W.J. Ruppert