


T. 35 S.R. 14 W. W. M.

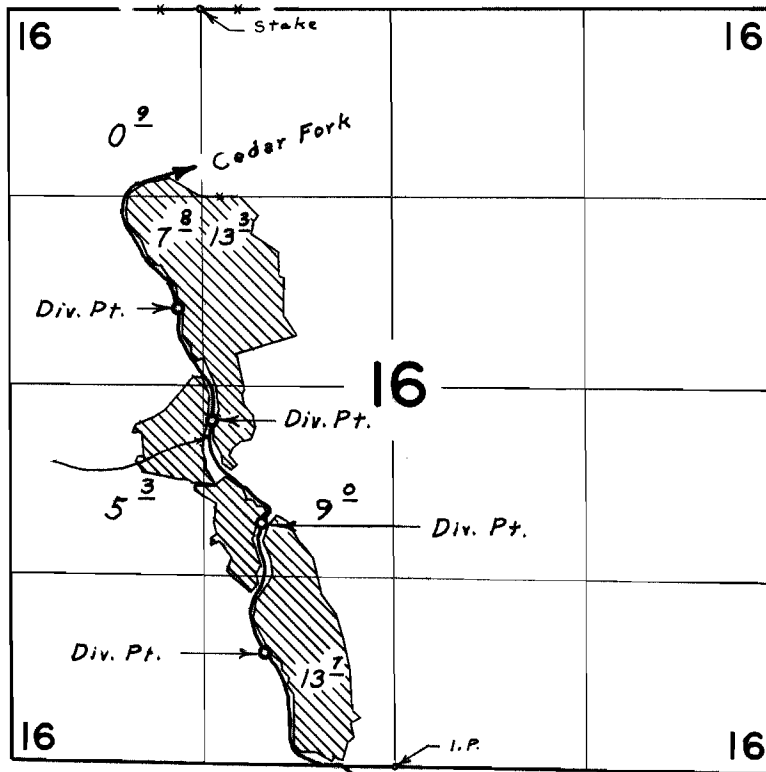

Div. Pts. located; 3160' N. & 1470' W., 2380' N. & 1230' W., 1680' N. & 910' W.,
790' N. & 880' W., all from S. $\frac{1}{4}$ Cor. Sec. 16

FINAL PROOF SURVEY UNDER

Application No. 39778 Permit No. 29492
IN NAME OF

W. & E. MILLER RANCHES INC.

Surveyed Sept. 22 1969, by V. GARNER