


T. 40 S. R. 13 W. W.M.

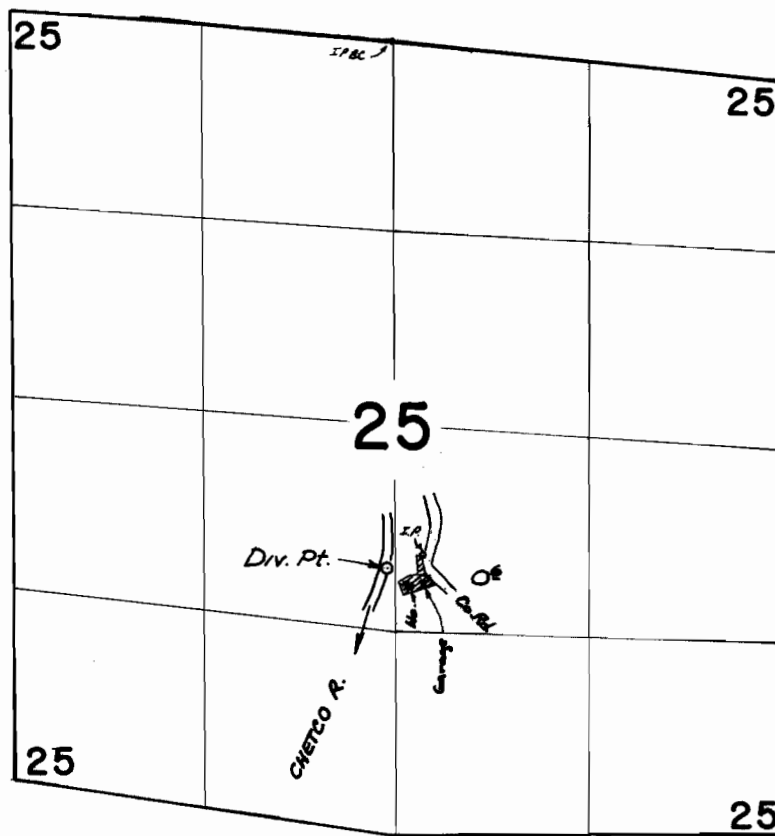

Div. Pt. located 9610' 3. & 50' W. from N $\frac{1}{4}$ cor. Sec. 25.

FINAL PROOF SURVEY
UNDER

Application No. 39705 Permit No. 29543
IN NAME OF

MADGE G. JOHNSON & ESTATE OF WILLIAM F. JOHNSON

Surveyed 9 SEPT. 1969, by L. E. GOULD