


T.31S.R.15W.W.M.

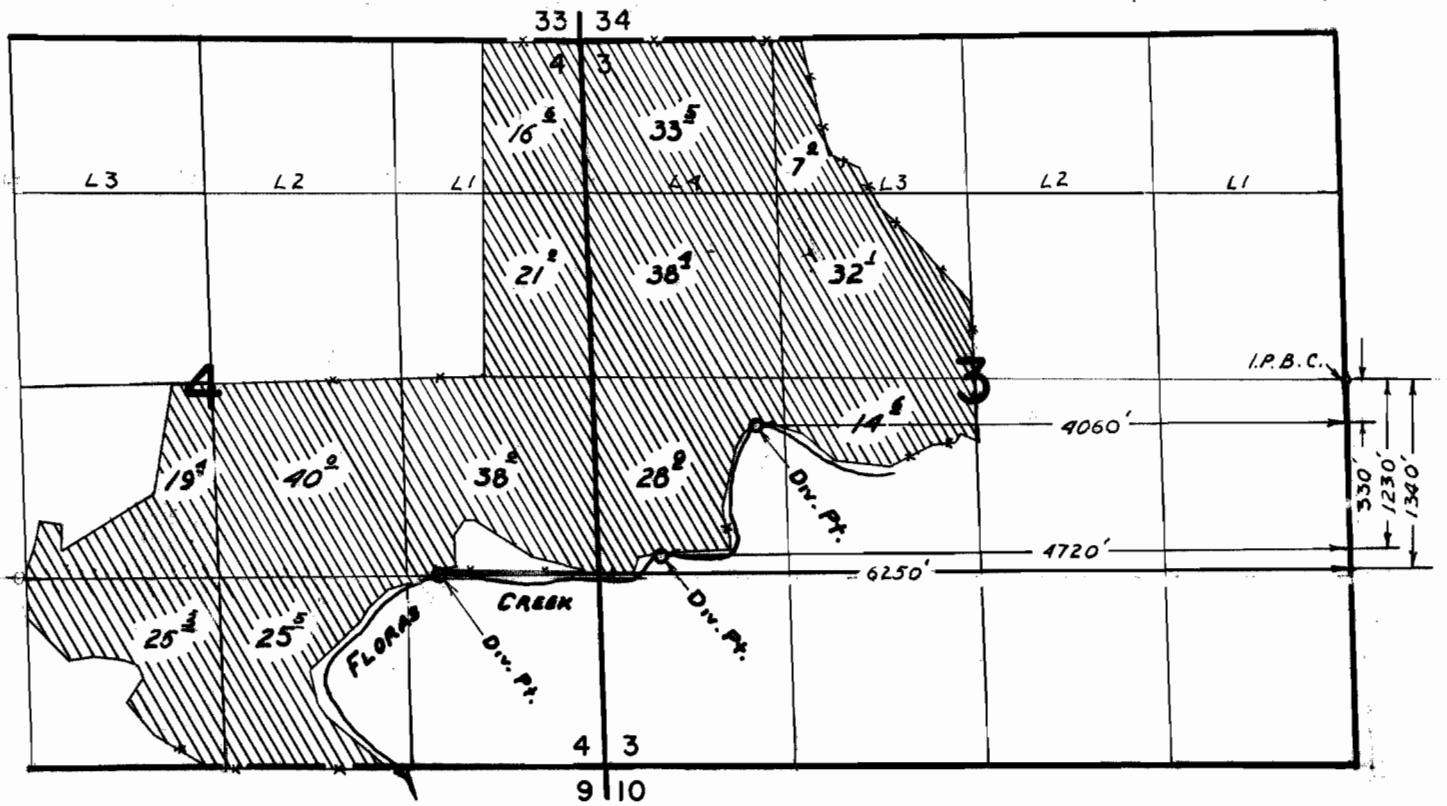

FINAL PROOF SURVEY
UNDER

Application No. 39763. Permit No. 29772.
IN NAME OF

RODERICK T. McKENZIE

Surveyed May 17, 1969, by L. E. Gould