


T.40S.R.14W.W.M.

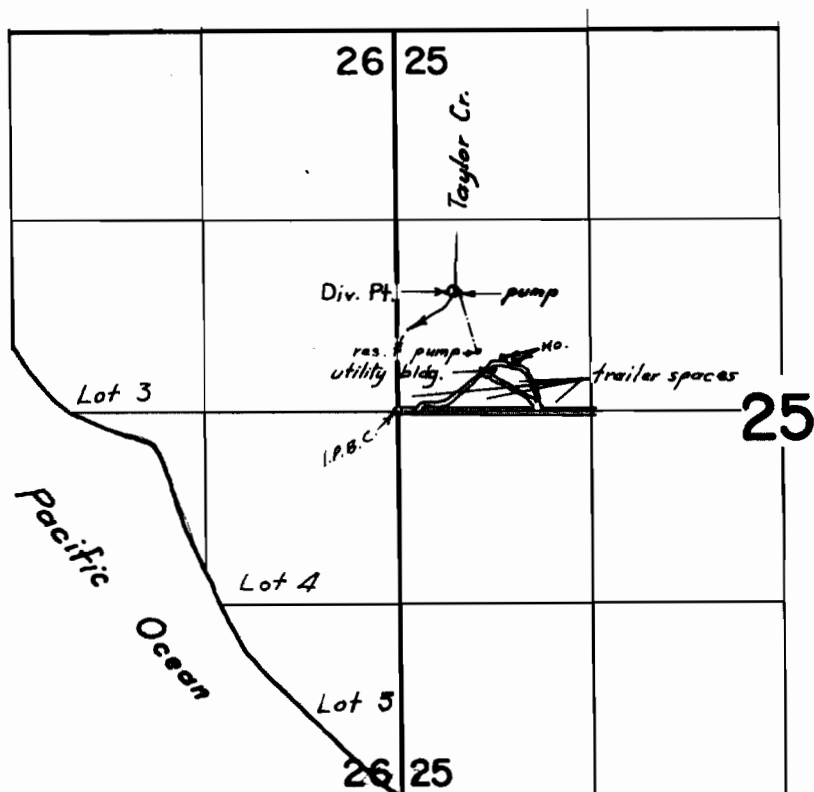

Div. Pt. located: 840 ft. N. & 390 ft. E. from W. $\frac{1}{4}$ cor. Sec. 25.

FINAL PROOF SURVEY
UNDER

Application No. 40299 Permit No. 30057
IN NAME OF

CARL L. JOHNSON

Surveyed Sept. 16, 1969, by L. E. Gould