


T.35S.R.11W.W.M.

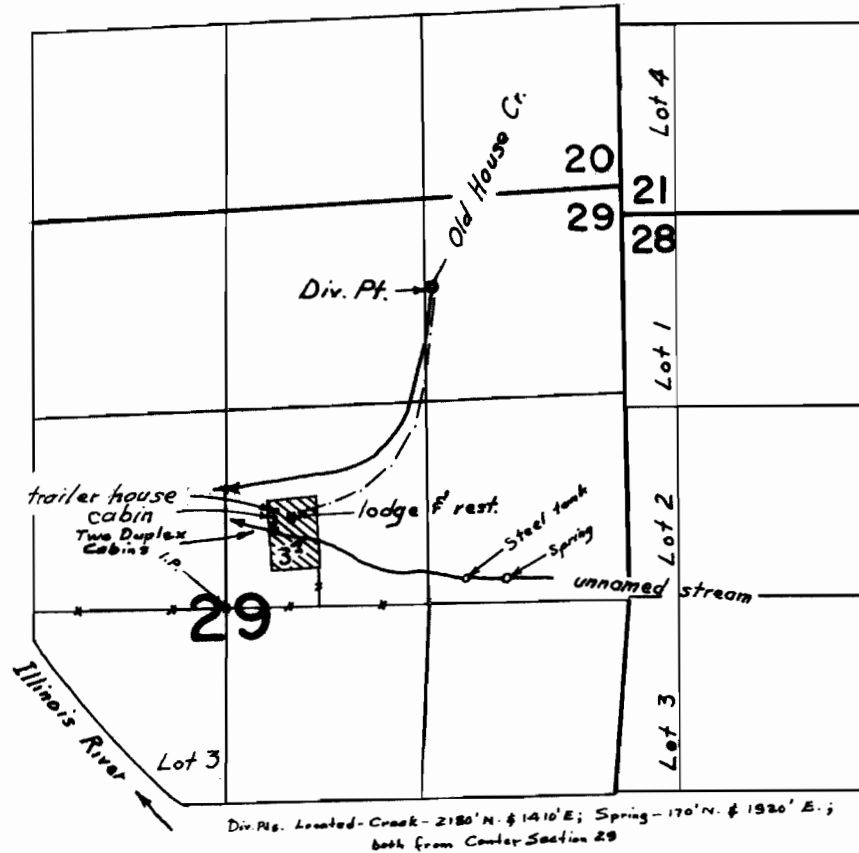

FINAL PROOF SURVEY
UNDER

Application No. 40330 Permit No. 30204
IN NAME OF

JOSEPH ROBERT DOYLE

Surveyed Sept. 18 1969, by L. E. Gould