


6/9/99

W HAD

# T. 33 S. R. 10 E. W.M.

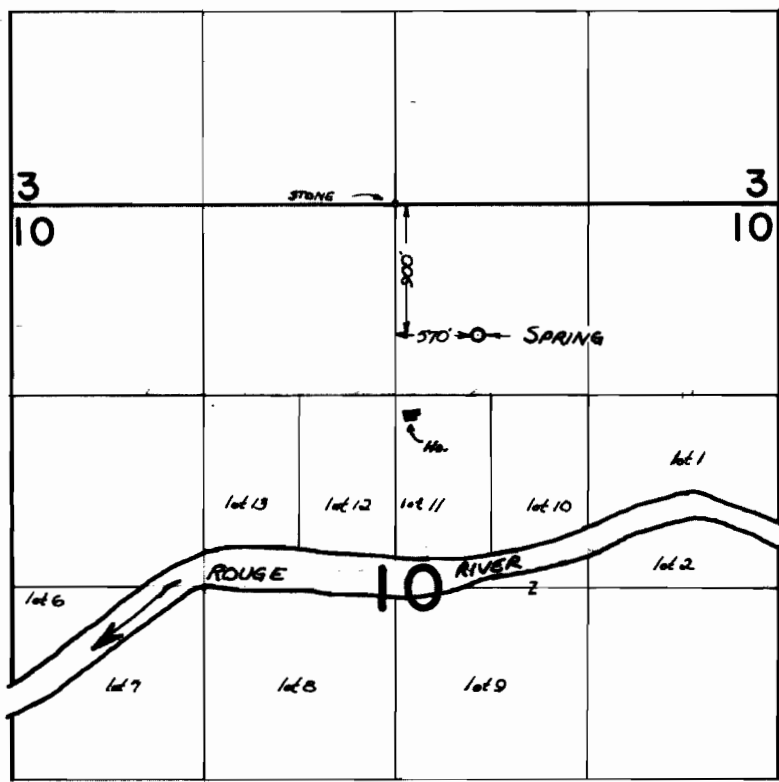

## FINAL PROOF SURVEY UNDER

Application No. 40351 Permit No. 30306  
IN NAME OF

**WILLIAM HENRY STEWART**

Surveyed 19 SEPT. 1969, by L. E. GOULD