


T.38S.R.14W.W.M.

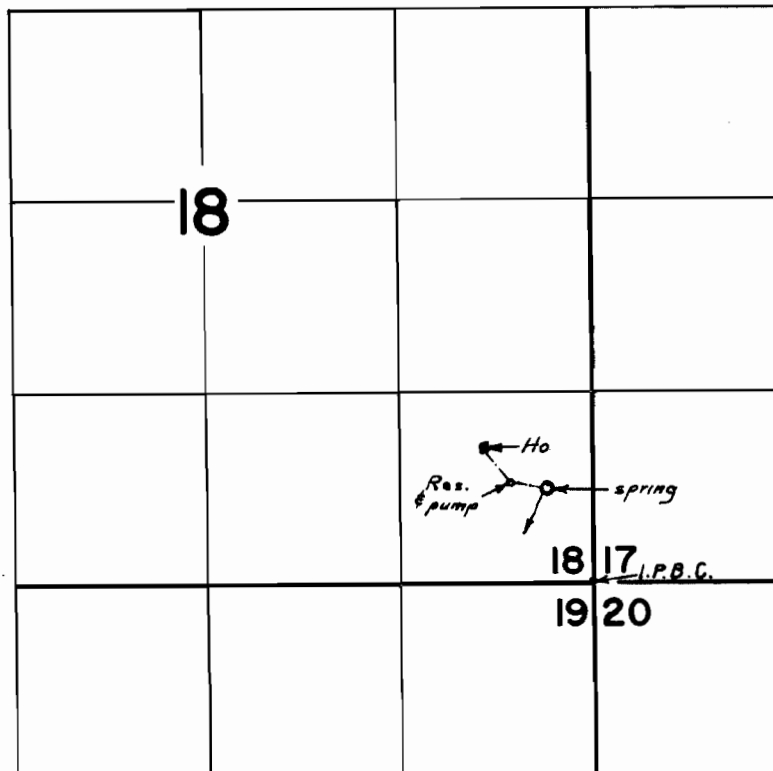

Spring located: 650 ft. N. & 320 ft. W. from S.E. cor. Sec. 18.

FINAL PROOF SURVEY
UNDER

Application No. 42406 Permit No. 31739
IN NAME OF

DAVID C. & IRENE L. GREEN

Surveyed Aug. 26, 1969, by L. E. Gould