


T. 40 S. R. 14 W. W.M.

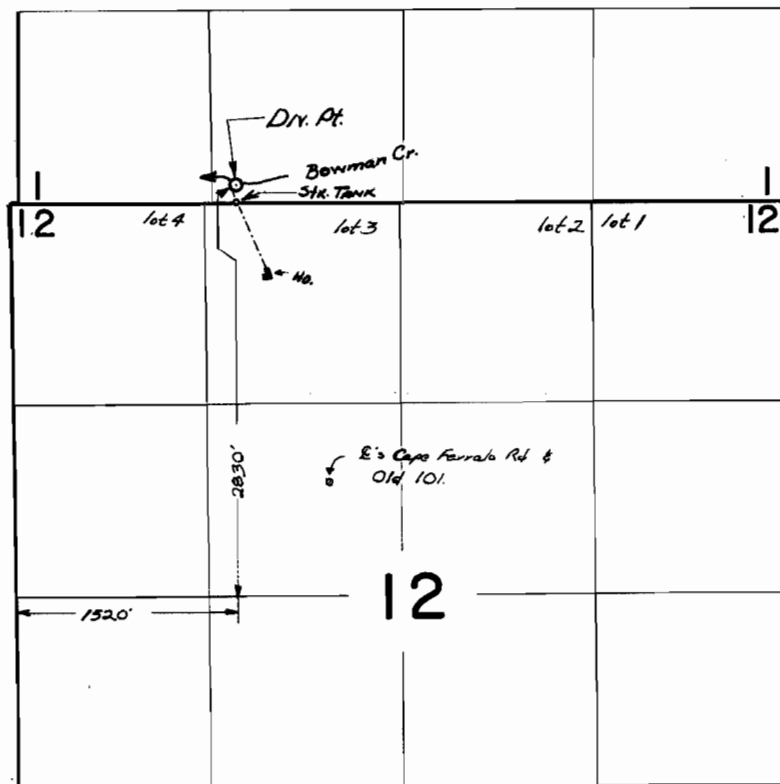

FINAL PROOF SURVEY
UNDER

Application No. 42867... Permit No. 31947...
IN NAME OF

ROY E. & RUTH E. COLLINS

Surveyed 16 SEPT. 1969, by L. E. GOULD