


T.39S.R.14W.W.M.

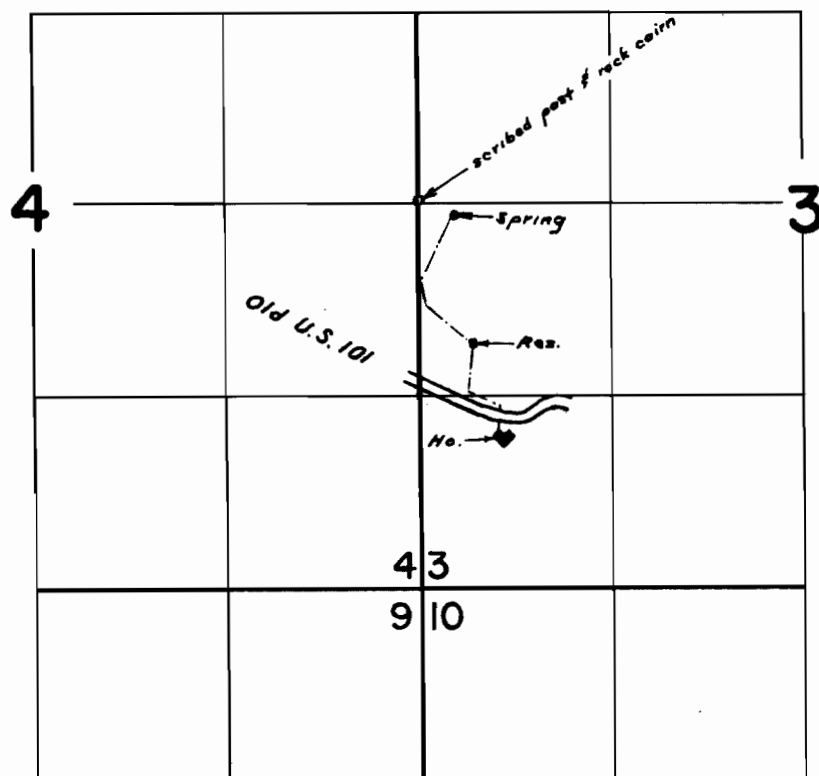

Spring located: 80 ft. S. & 250 ft. E. from W 1/4 cor. Sec. 3.

FINAL PROOF SURVEY
UNDER

Application No. 43137 Permit No. 32226
IN NAME OF

CHRIST & ESTHER WILLIAMS

Surveyed Aug. 27, 1969, by L. E. Gould