


T.35S.R.14W.W.M.

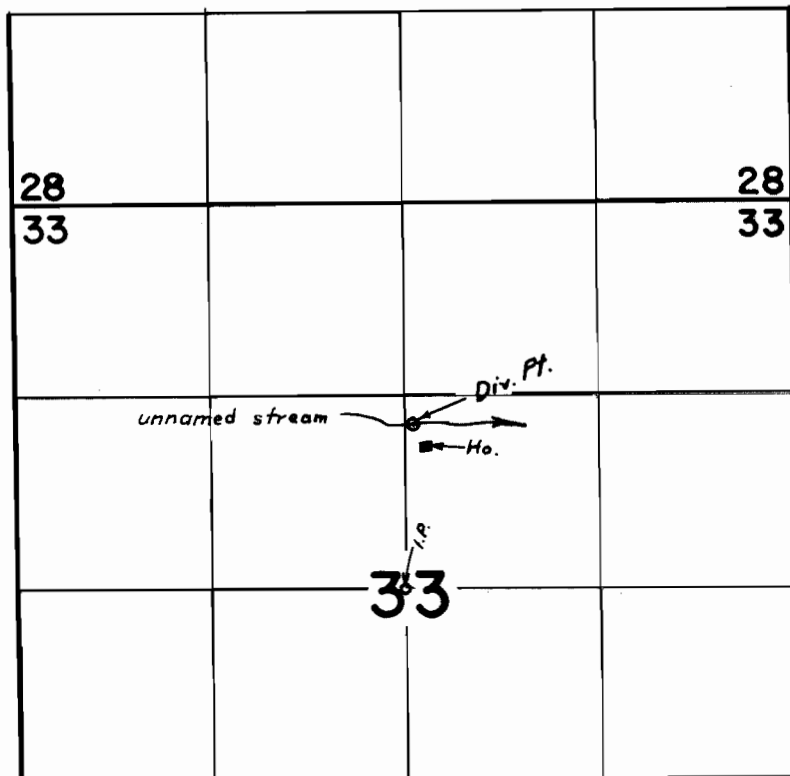

Div. Pt. located: 1120 ft. S. & 60 ft. E. from cen. Sec. 33.

FINAL PROOF SURVEY
UNDER

Application No. 43360 Permit No. 32407
IN NAME OF

DAWN WATSON

Surveyed Aug. 20 1969, by L. E. Gould