


T. 21 S. R. 4 W. W. M.

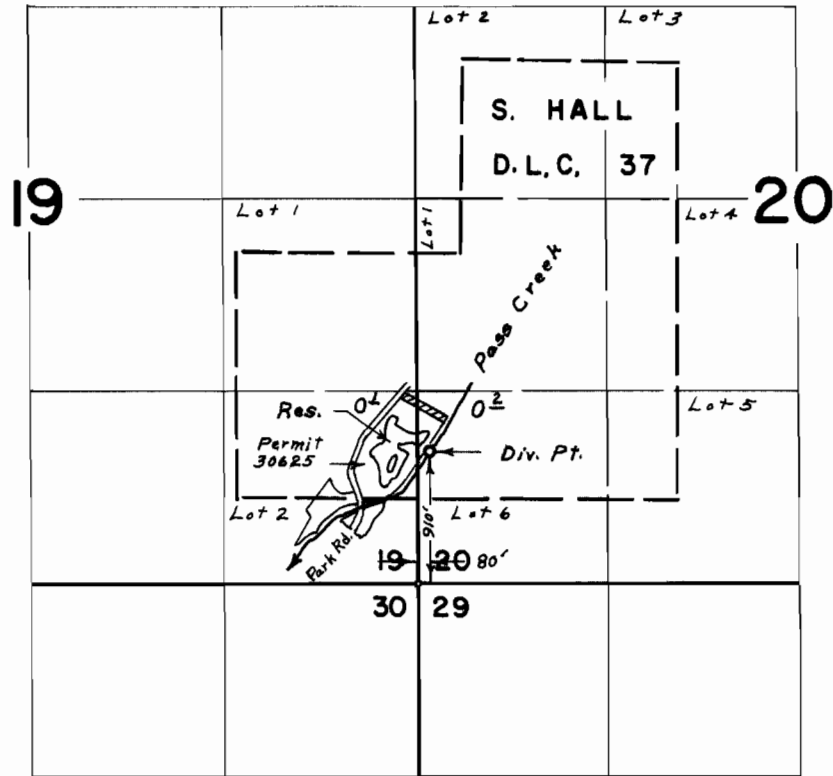

FINAL PROOF SURVEY
UNDER

Application No. 37540 Permit No. 27975
IN NAME OF

DOUGLAS COUNTY

Surveyed MAY 13, 1966, by L. E. Gould