


T. 29 S. R. 9 W. W.M.

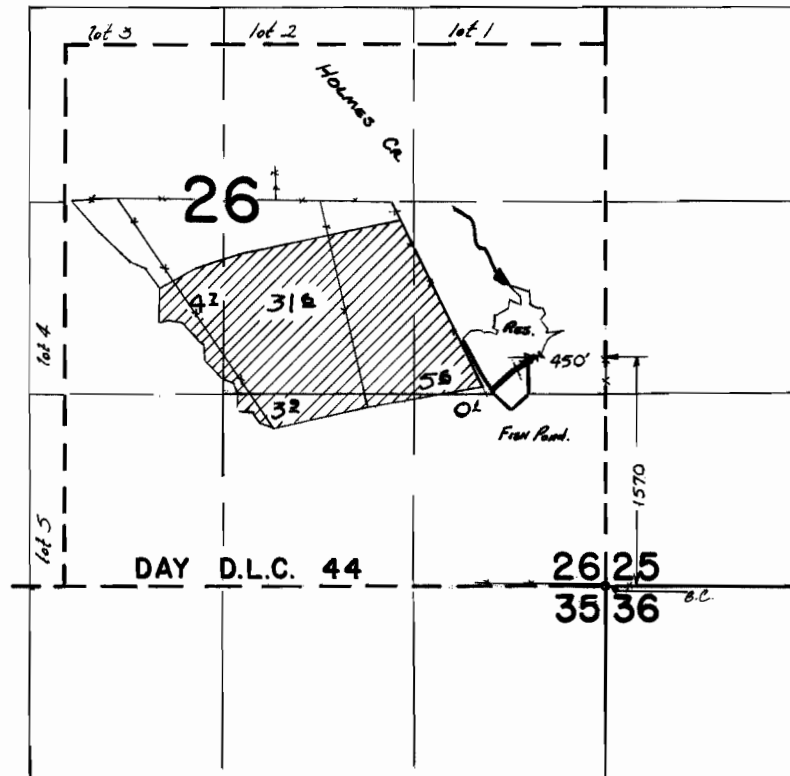

FINAL PROOF SURVEY
UNDER

38318 29763
Application No. R38679 Permit No. R 4128
IN NAME OF

HENRY A. DENN

Surveyed 9 SEPT. 1969, by W. J. RUPPERT

W. J. RUPPERT