


T.13S. R.29E.W.M.

6
P 27375
36873

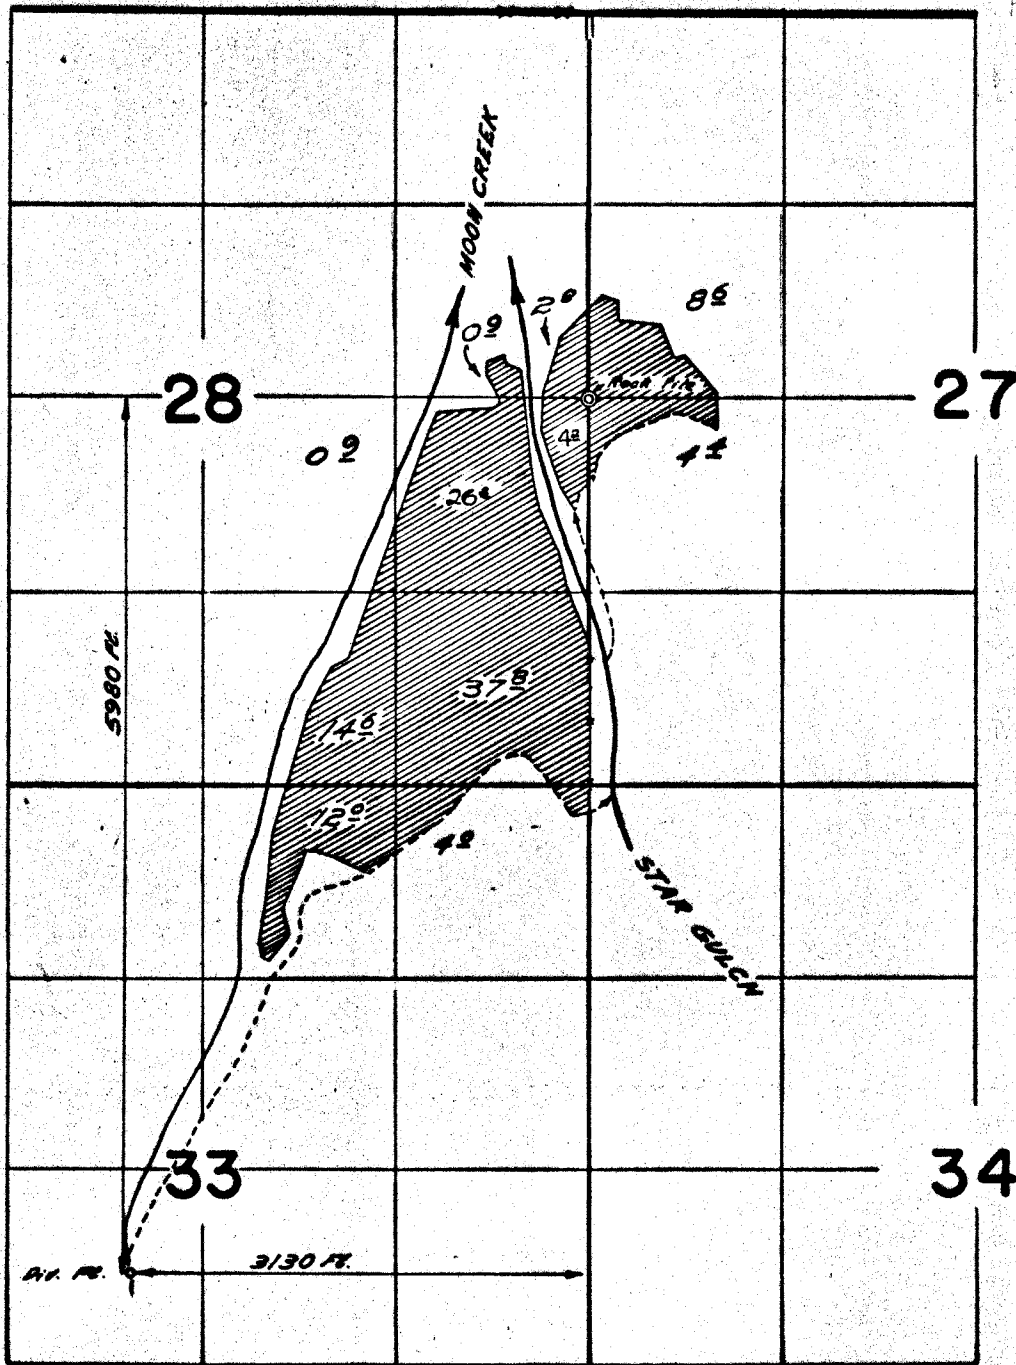

FINAL PROOF SURVEY
UNDER

Application No. 34880. Permit No. 27375
IN NAME OF

UNA POPE

Surveyed July 16 1968, by W. J. Reynolds