


T.13S.R.27E.W.M.

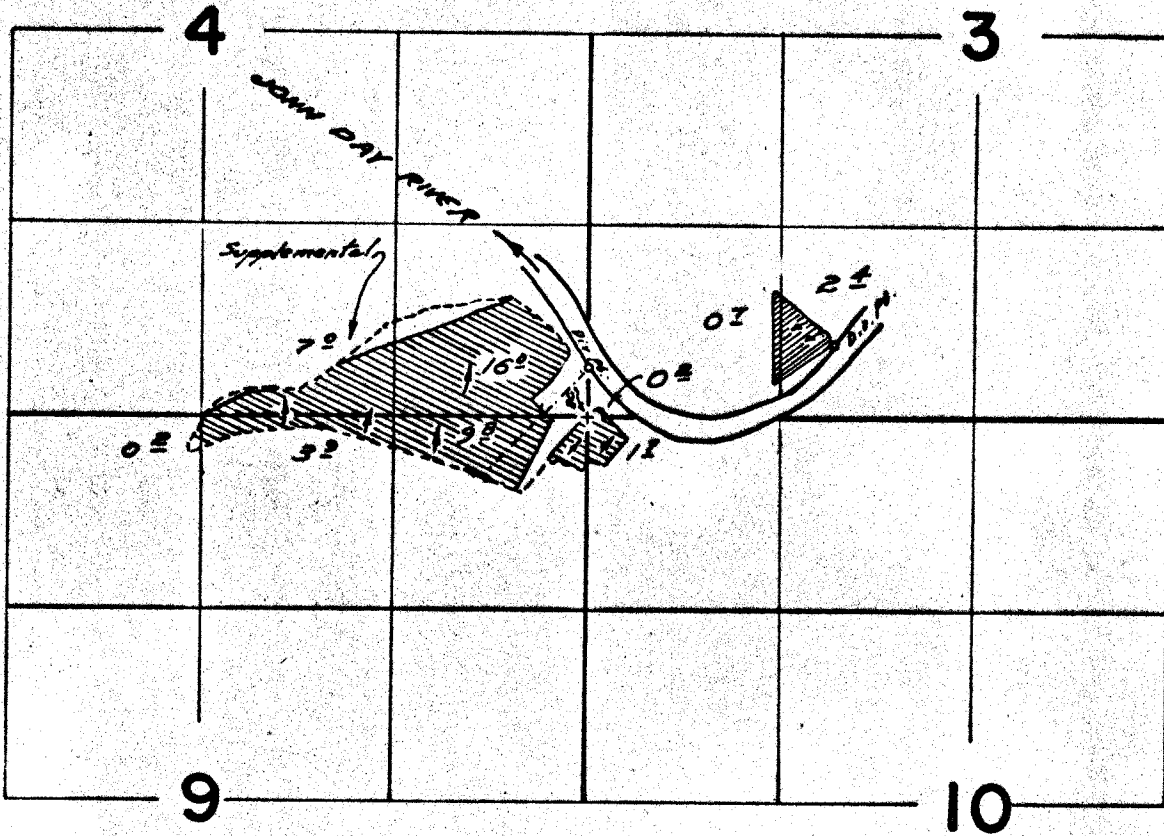

Diversion points located 340 ft. N. & 10 ft. W., & 500 ft. N. & 1670 ft. E.; both from the corner common to Sections 3, 4, 9, & 10.

FINAL PROOF SURVEY UNDER

Application No. 37605 Permit No. 28045
IN NAME OF

GEORGE MACKAY

Surveyed May 22 1968 by W. A. Ruppert