


P 28491
36875

T.16S.R.28E.W.M.

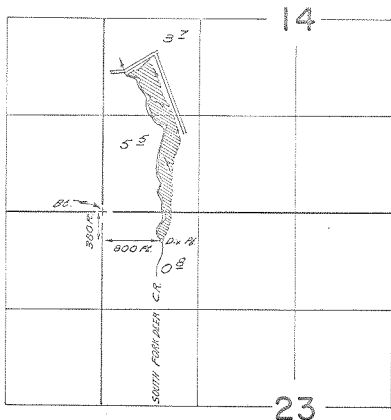

FINAL PROOF SURVEY
UNDER

Application No. 36250 Permit No. 28491
IN NAME OF

U.S. DEPARTMENT OF AGRICULTURE

Surveyed July 13 1960, by *W. L. Ruppert*.