


6  
P 29257  
36876

T.13S.R.34E.W.M.

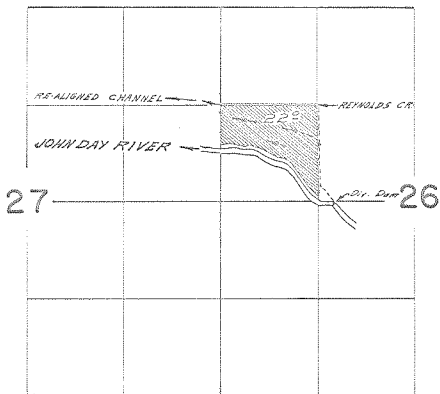

DIVERSION POINT LOCATED 1350 F.S. & 200 F.E. FROM  
N.E. Cor. SW1/4 NW1/4 SECTION 26

FINAL PROOF SURVEY  
UNDER

Application No. 29283, Permit No. 29257  
IN NAME OF

*FRENCH & DRINKWATER*

Surveyed July 12 1968, by *H. J. Pappas*