


P 29854
36877

T.13S. R.29E.W.M.

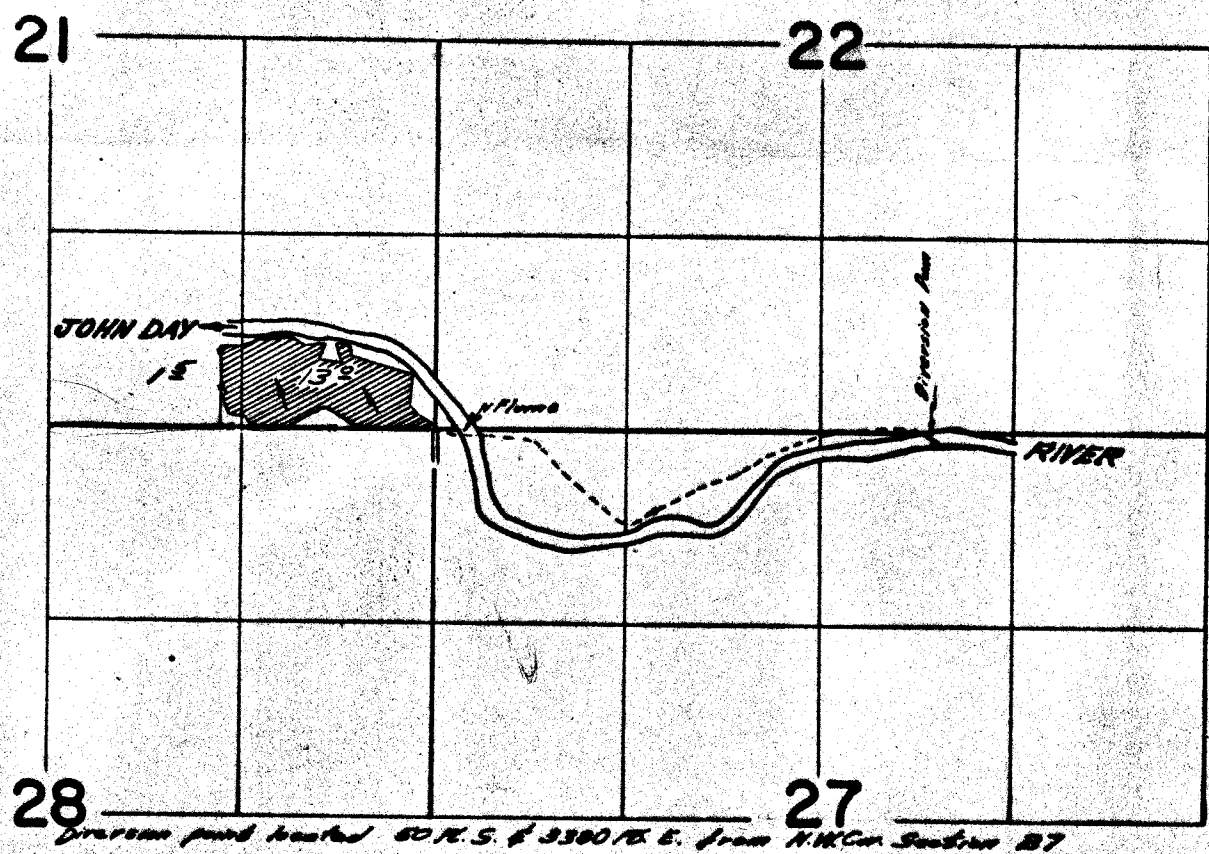

FINAL PROOF SURVEY UNDER

Application No. 10012... Permit No. 29854
IN NAME OF

CHARLIE L. PAGE

Surveyed July 15 1968, by W.D. Flippert