


T. 22 S. R. 32 $\frac{1}{2}$ E. W.M.

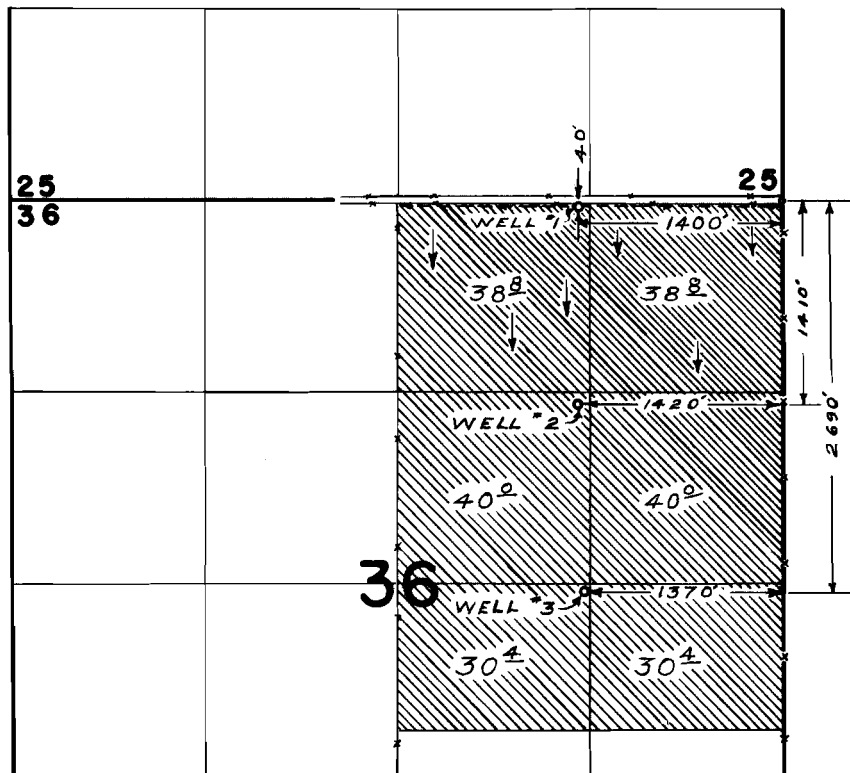

FINAL PROOF SURVEY UNDER

Application No. G-2926 Permit No. G-2716
IN NAME OF

RICHARD & GLENDA TEMPLE

Surveyed SEPT. 14, 1968, by W. J. RUPPERT