


T. 22S.R.31E.W.M.

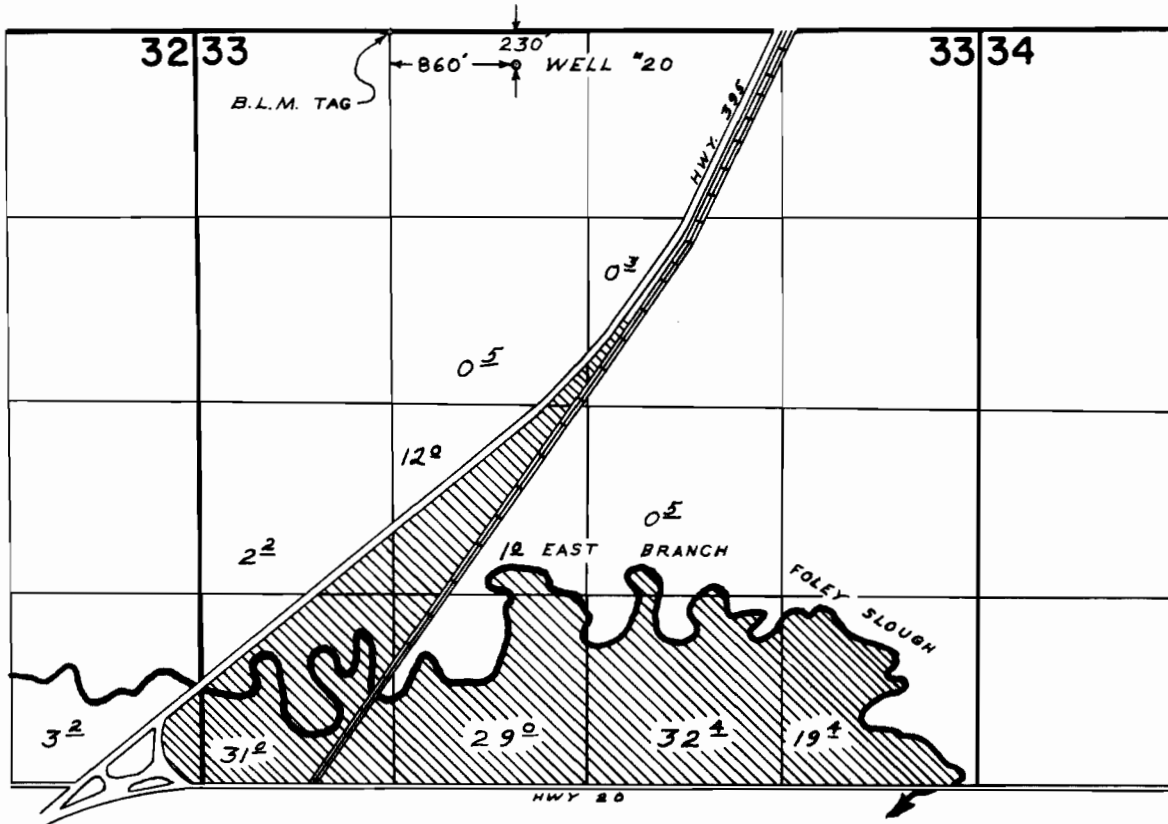

FINAL PROOF SURVEY UNDER

Application No. G-3083 Permit No. G-2880
IN NAME OF

HARRY PON

Surveyed SEPT. 16, 1968, by W. J. RUPPERT