


T.22S.R.31E.W.M.

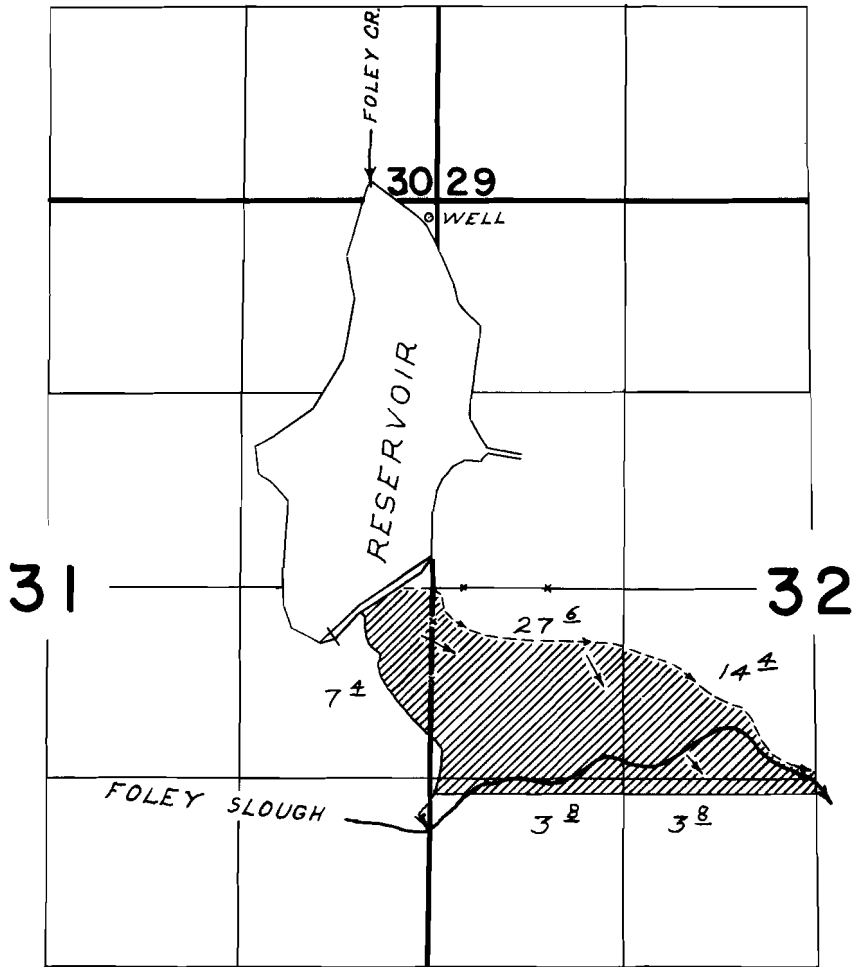

WELL LOCATED 2530' N & 60' W FROM E 1/4 COR. SEC. 31

FINAL PROOF SURVEY
UNDER

Application No. G-4152 Permit No. G-3904
IN NAME OF

HARRY PON

Surveyed SEPT. 15, 1968, by W. J. RUPPERT