


T.24S.R.33&34E.W.M.

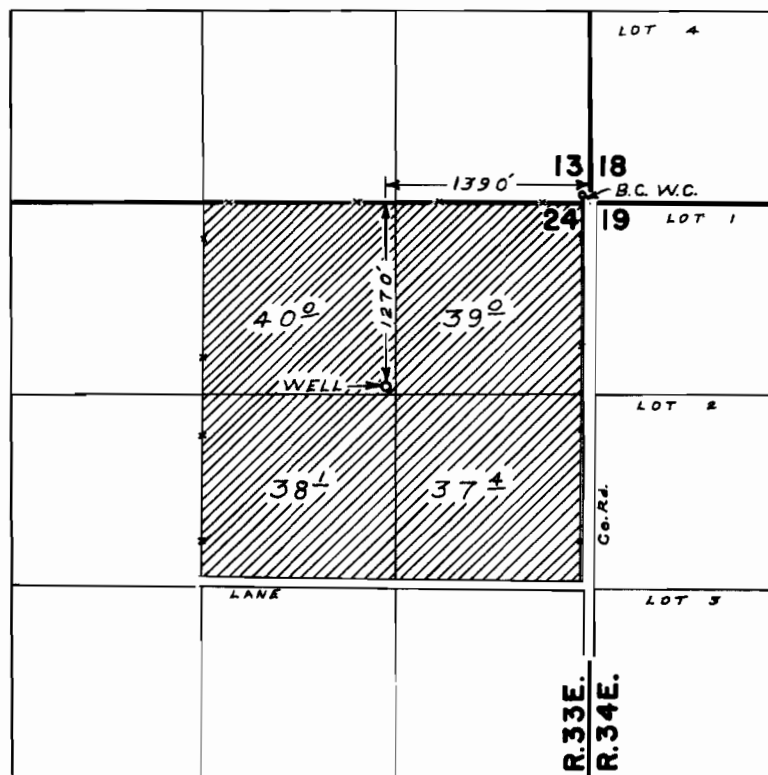

FINAL PROOF SURVEY
UNDER

Application No. G-3502 Permit No. G-3091
IN NAME OF

RICHARD H. STRAW

Surveyed SEPT. 10, 1968, by W. J. RUPPERT