


T. 23 S. R. 27 E. W.M.

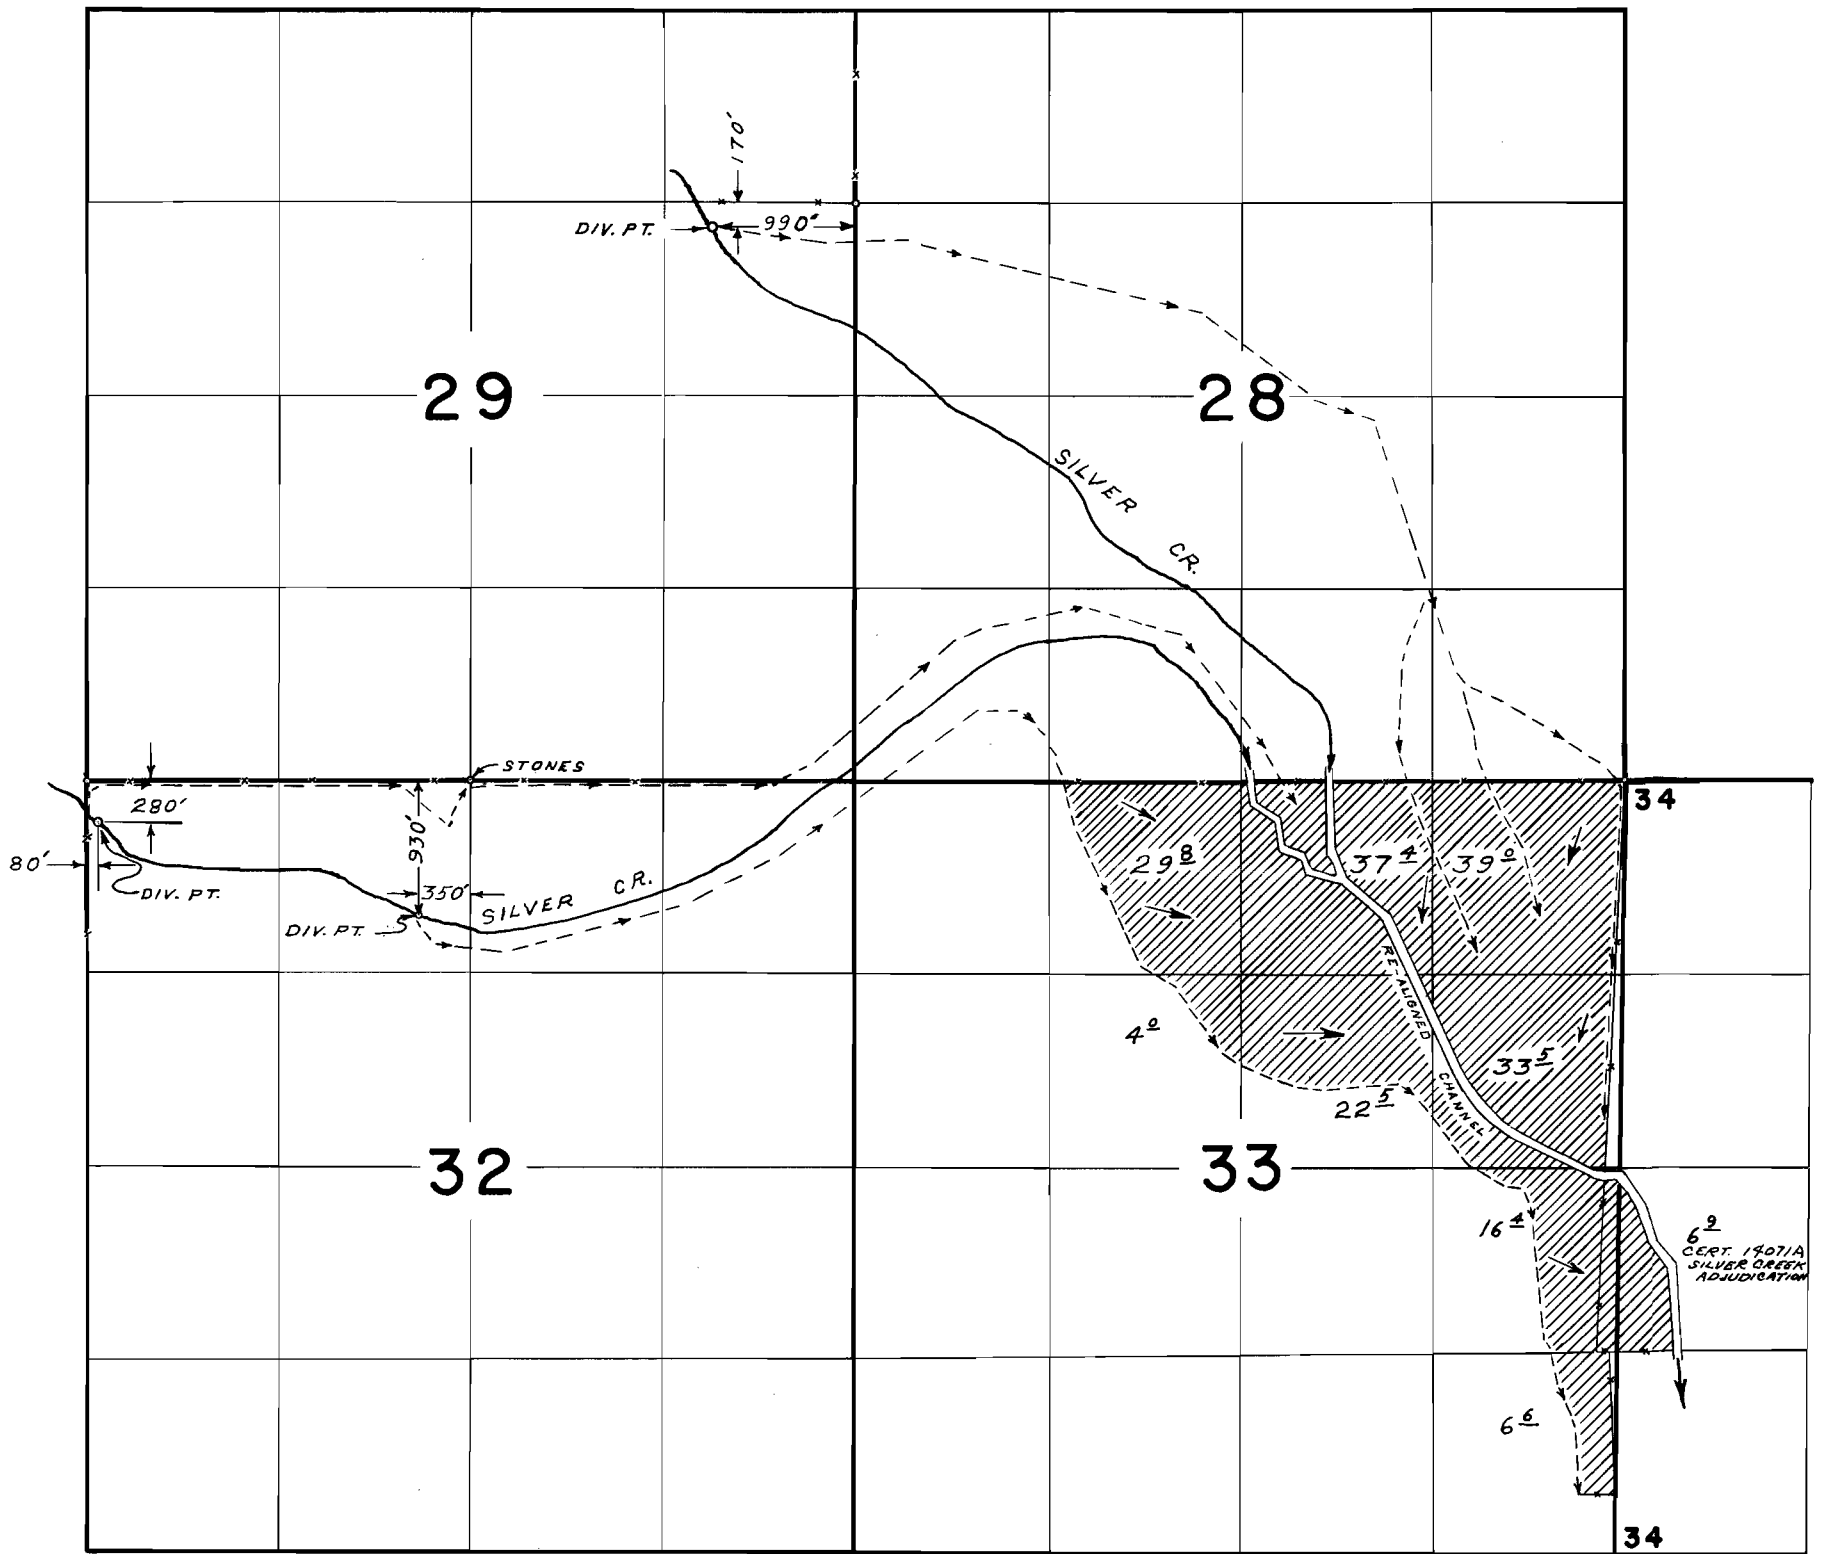

FINAL PROOF SURVEY

UNDER

Application No. **34966** Permit No. **27423**

IN NAME OF

HOTCHKISS COMPANY INC.

Surveyed **SEPT. 19 1968**, by **W. J. RUPPERT**