


T. 38 S. R. 4 W. W.M.

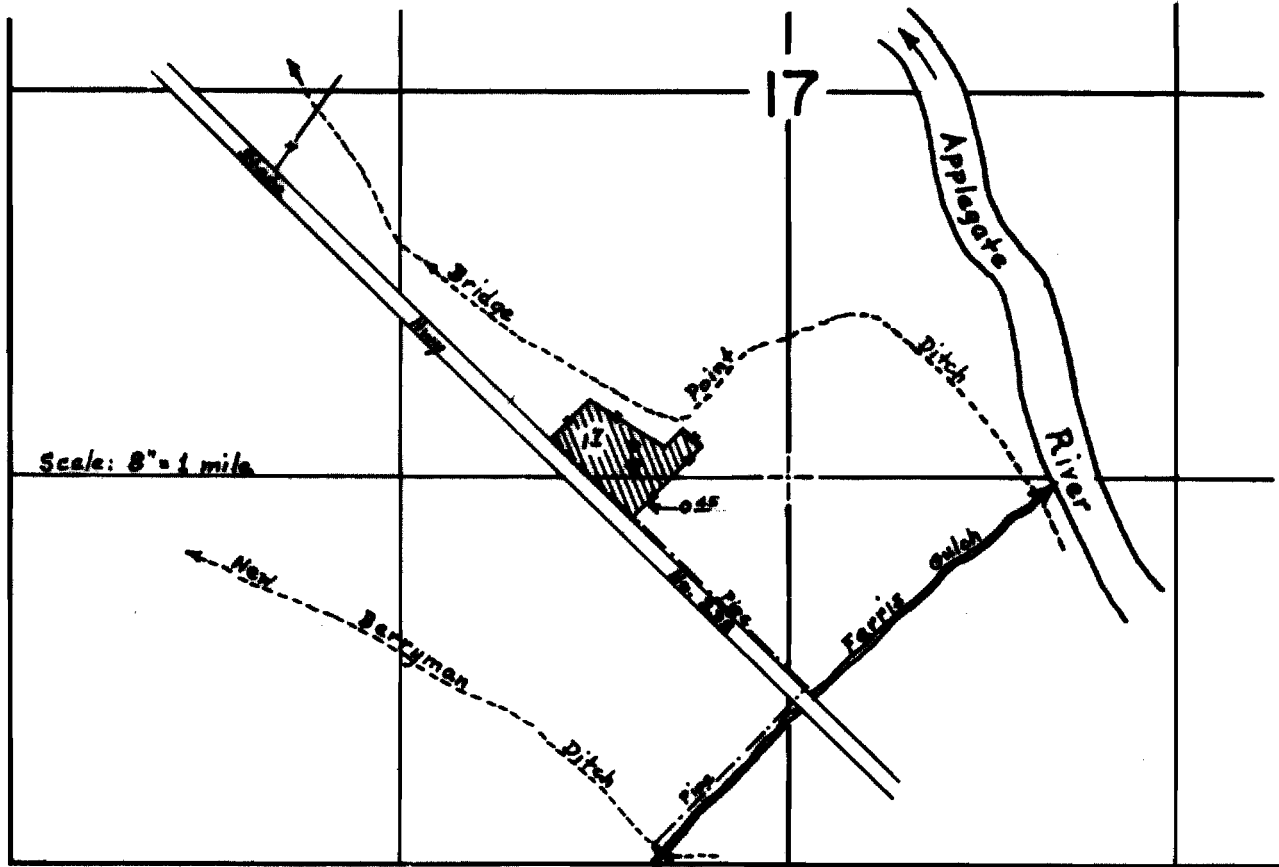

New Berryman Ditch diversion point is located
1050' S. and 500' W. from the N $\frac{1}{4}$ cor. Sec. 25

FINAL PROOF SURVEY
UNDER

Application No. 40810 Permit No. 30406.
IN NAME OF

W. M. & Joe F. Sullivan

Surveyed Dec. 10, 1969, by D. C. Handrix.