


R 2705

36889

T.37S. R.20E.W.M.

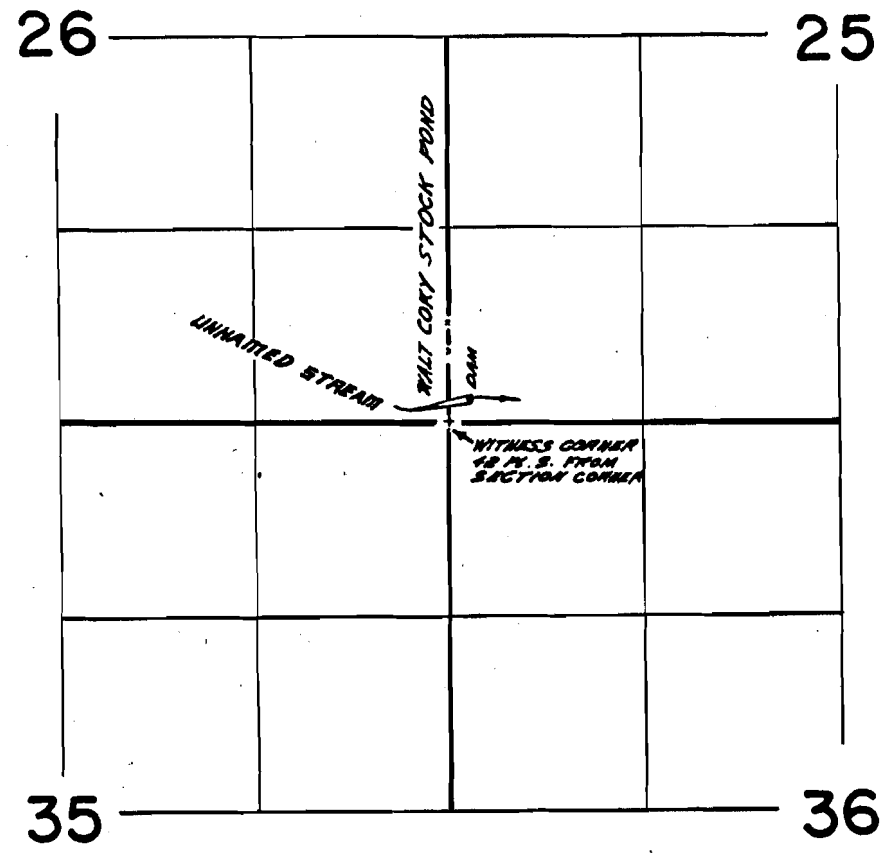

FINAL PROOF SURVEY UNDER

Application No. *R-37128* Permit No. *R-2705*
IN NAME OF

WALTER M. CORY

Surveyed *August B. 1968*, by *W.D. Ruggert*

37-20 ✓