


T.38S. R.18E.W.M.

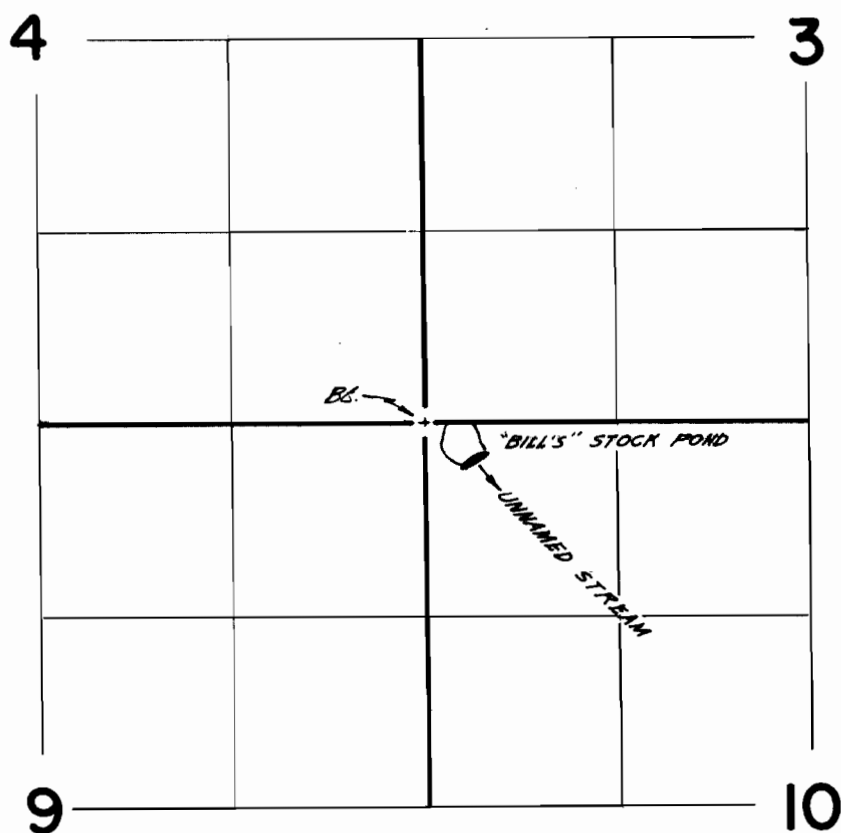

FINAL PROOF SURVEY
UNDER

Application No. ~~R-19276~~ Permit No. ~~R-1995~~
IN NAME OF

FAVELL-UTLEY CORPORATION

Surveyed *Aug. 2* 1968, by *W.O. Ruppert*