


T. 6 & 7 S. R. 10 W. W. M.

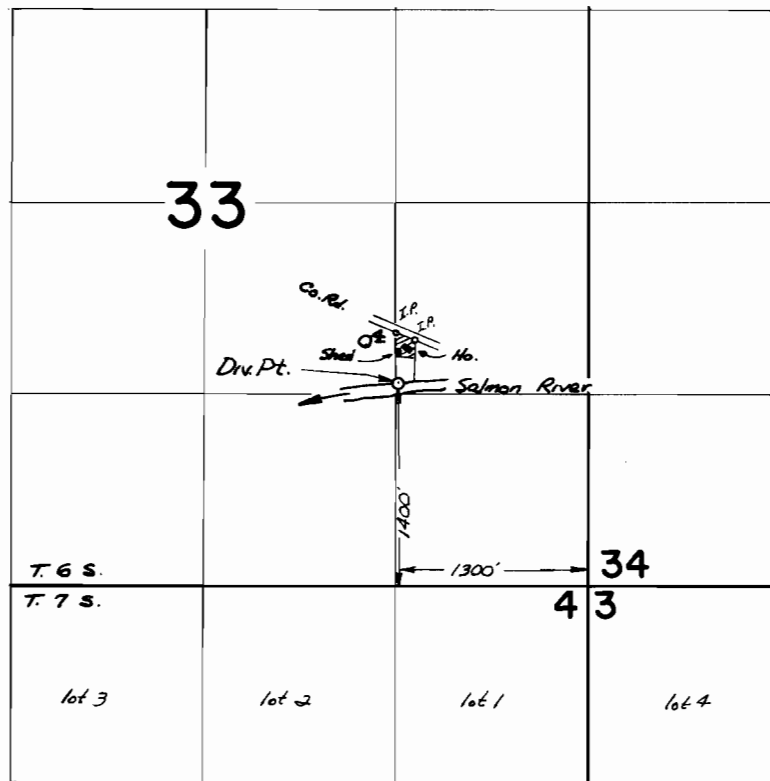

FINAL PROOF SURVEY UNDER

Application No. 41252..... Permit No. 30763.....
IN NAME OF

GLEN CLAUS SIEMS

Surveyed 29 JULY 1969, by L. E. GOULD