


T.7S.R.10W.W.M.

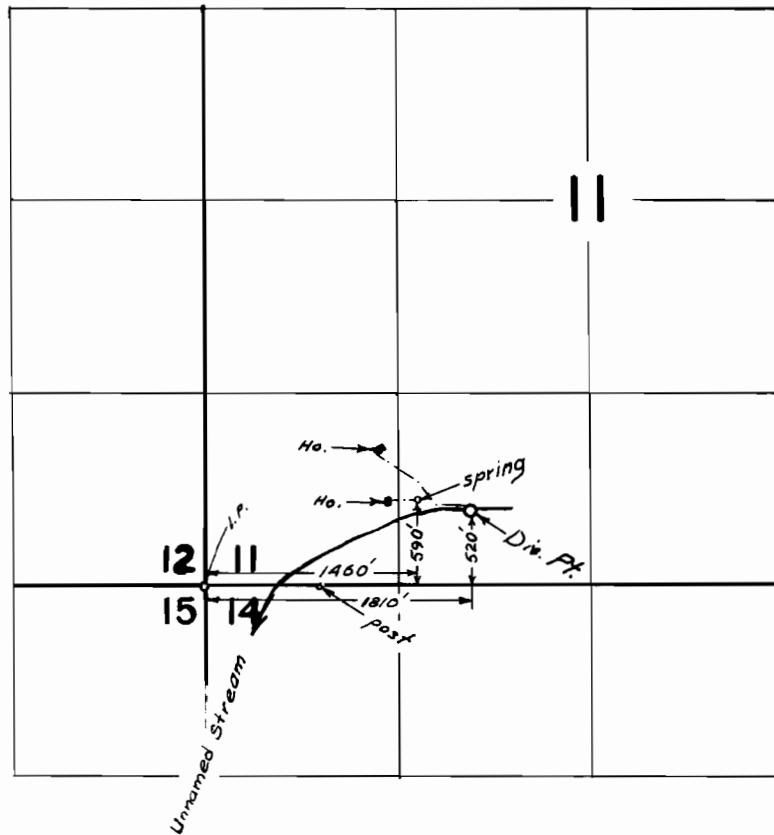

FINAL PROOF SURVEY
UNDER

Application No. **41398** Permit No. **30923**
IN NAME OF

VERNON & DONNA IMEL

Surveyed Oct. 1 1969, by L. E. Gould