


T.I.S.R.IOW.W.M.

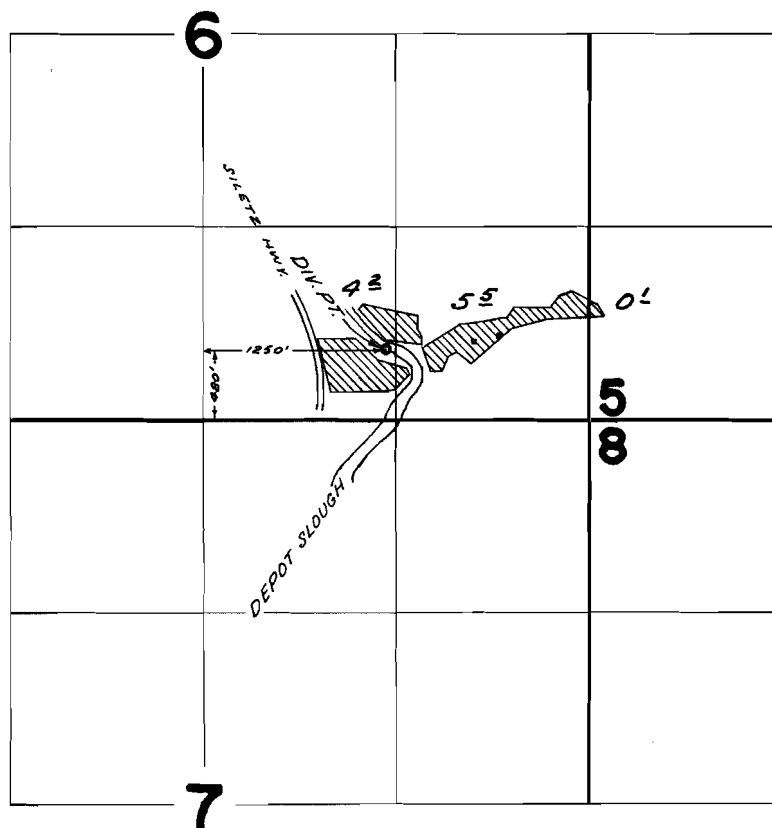

FINAL PROOF SURVEY
UNDER

Application No. 44088 Permit No. 32996
IN NAME OF

W. R. GIRARDELLI

Surveyed OCT. 4 1968, by W. J. RUPPERT