


T.13S.R.1E.W.M.

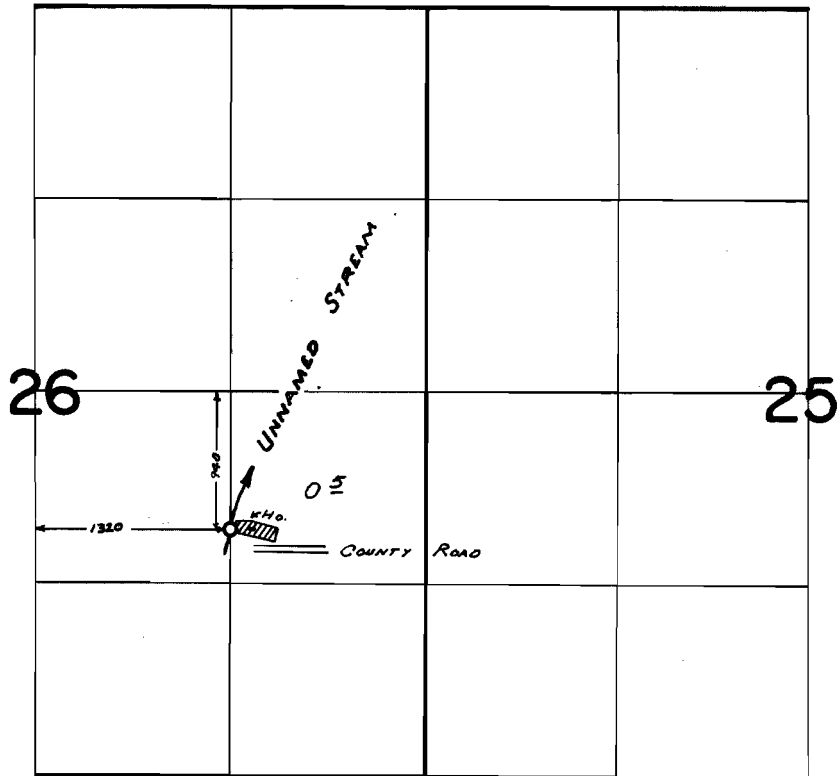

FINAL PROOF SURVEY UNDER

Application No. 39970 Permit No. 29896
IN NAME OF

JERRY & BETTY WATKINS

Surveyed APR. 24, 1969, by W. RUPPERT