


T. 15 S. R. 3 W. W. M.

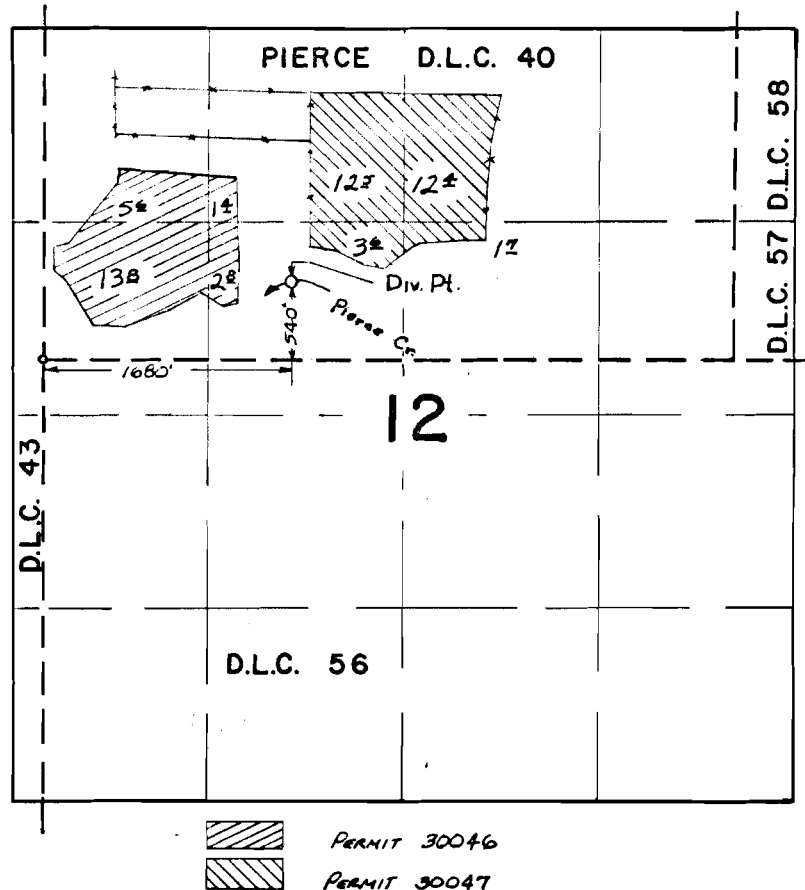

FINAL PROOF SURVEY
UNDER

40196 30046
Application No. 40197 Permit No. 30047
IN NAME OF

LESTER H. & MARY ANNA WALKER

Surveyed 18 SEPT. 1969, by W. J. RUPPERT