


# T. 14 S. R. 1 W. W. M.

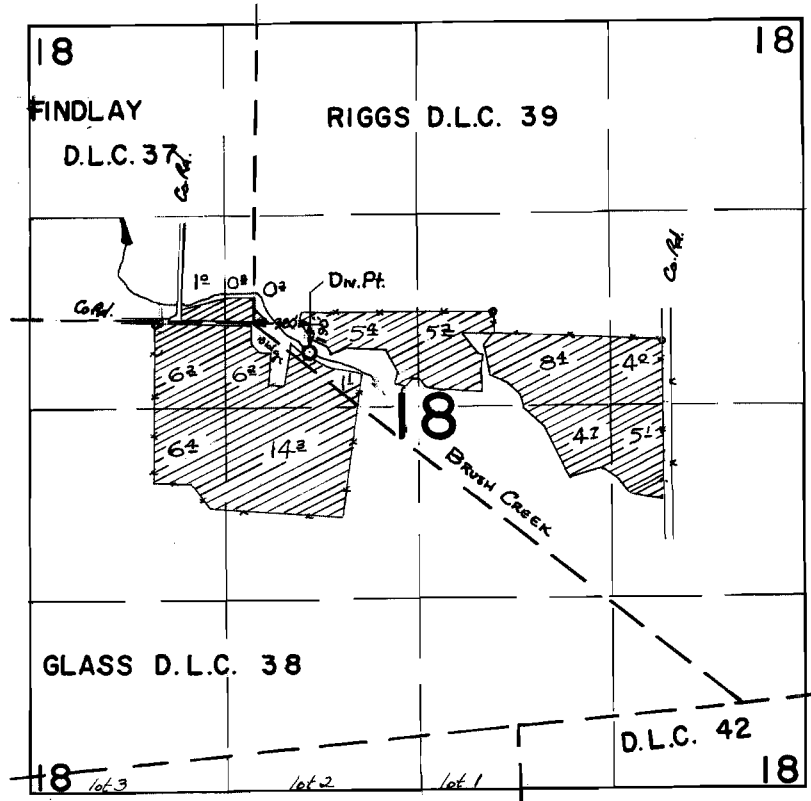

## FINAL PROOF SURVEY UNDER

Application No. 40302 Permit No. 30059  
IN NAME OF

DR. D. CRAIG & AGNES A. MARBLE

Surveyed 5 SEPT 1969, by W. J. RUPPERT