


T. 10 & 11 S. R. 1 W. W. M.

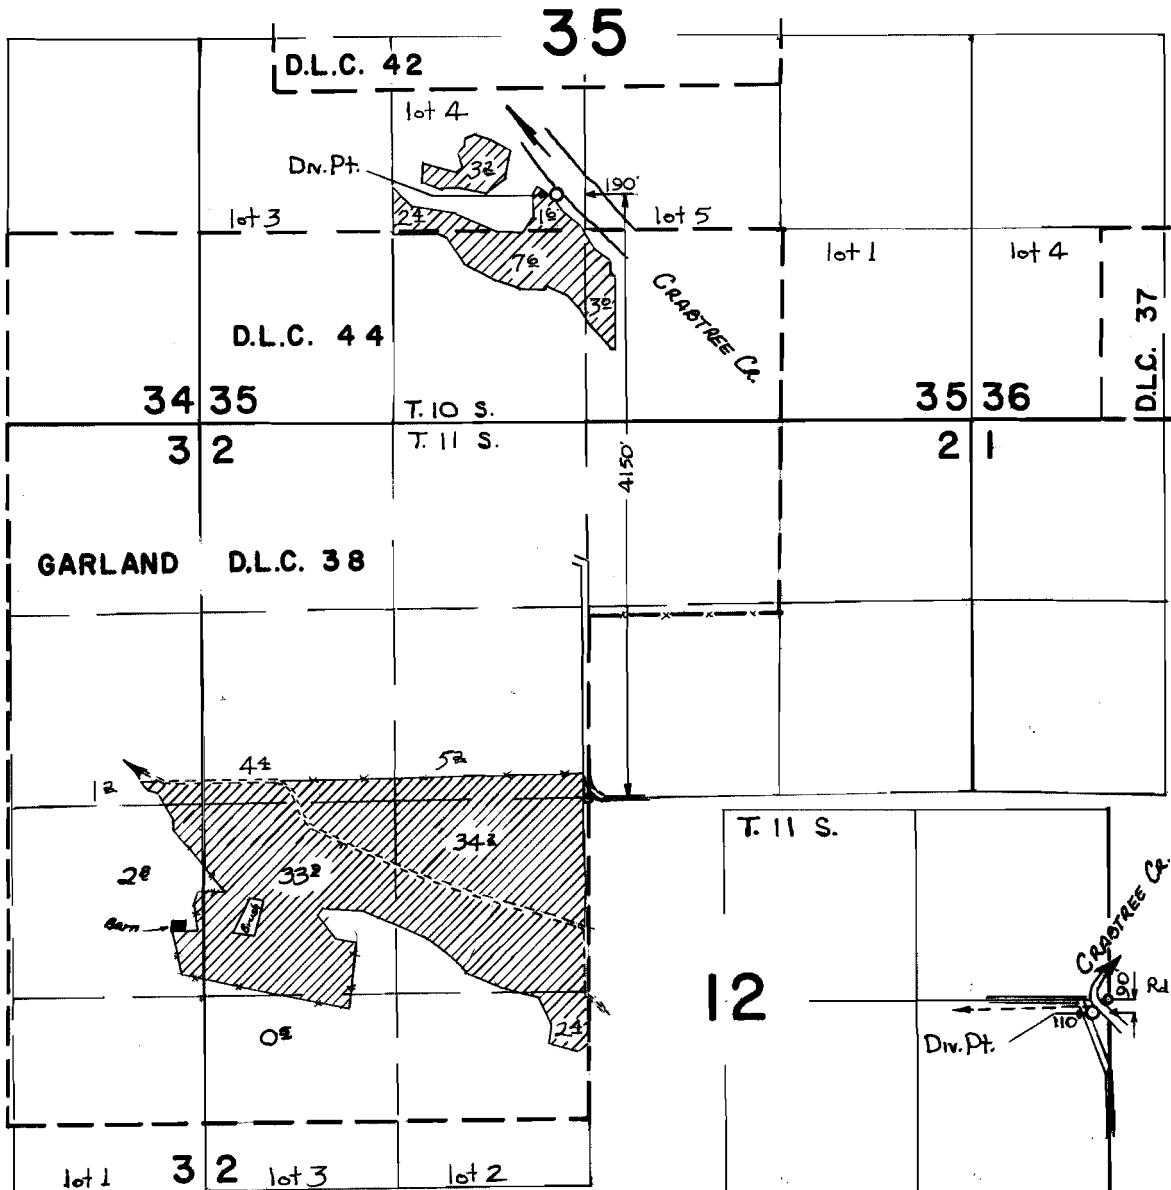

FINAL PROOF SURVEY UNDER

Application No. 40452... Permit No. 30154...
IN NAME OF

BERNARD A. & OLIVE MAE STEWART

Surveyed 1 AUG 1969, by W. J. RUPPERT
4 MAY 70 R. G. MUCKEN