


T.13S.R.1E.W.M.

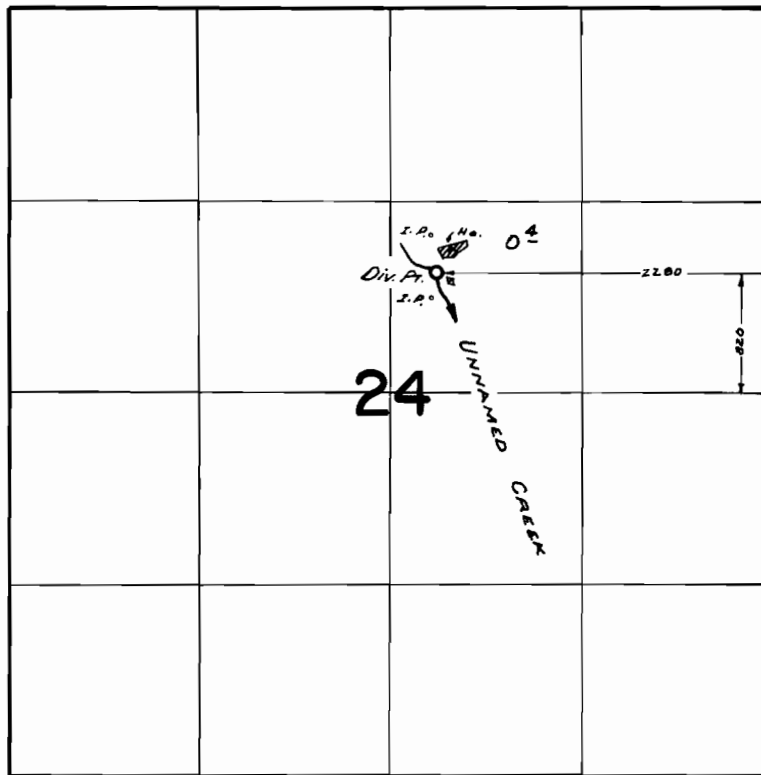

FINAL PROOF SURVEY
UNDER

Application No. 41273 Permit No. 30778
IN NAME OF

ROY E. & BETTY L. KIPP

Surveyed MAY 6, 1969, by W. RUPPERT.