


T.10S.R.2W.W.M.

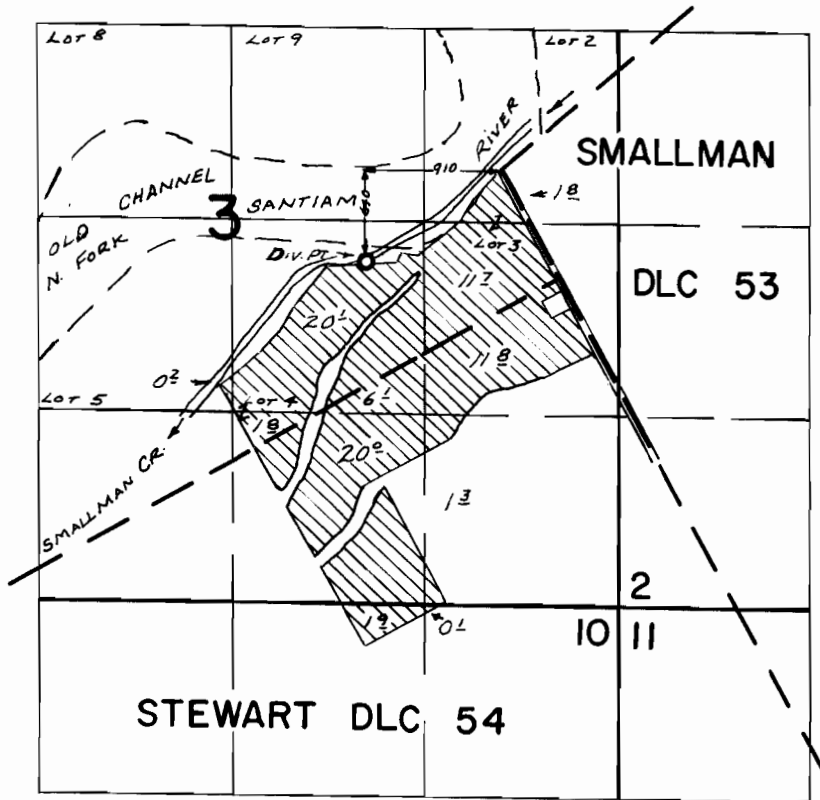

FINAL PROOF SURVEY UNDER

Application No. 41289 Permit No. 30830
IN NAME OF

VENUS STANDLEY, PEARL RICE & WILLIS D. SIMS

Surveyed MAR. 26, 1969, by W. RUPPERT.