


T. 14 S. R. 1 & 2 W. W.M.

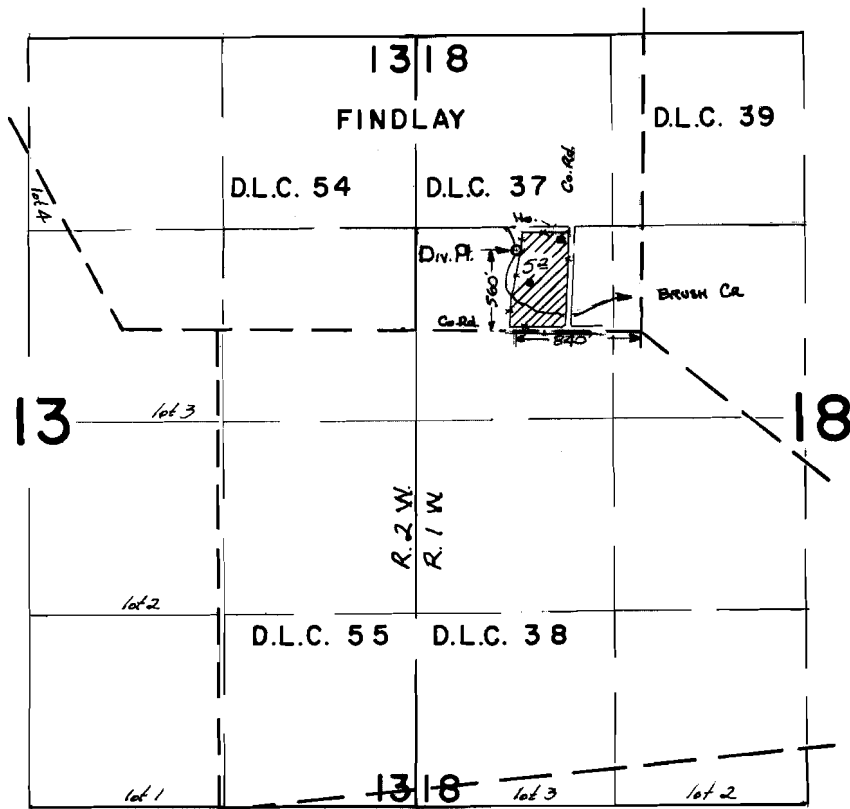

FINAL PROOF SURVEY UNDER

Application No. 43665 Permit No. 32643
IN NAME OF

HARVEY A. & VIOLA E. MULLINS

Surveyed 5 SEPT 1969, by W. J. RUPPERT