T. 7 S. R. 3 W. W.M.

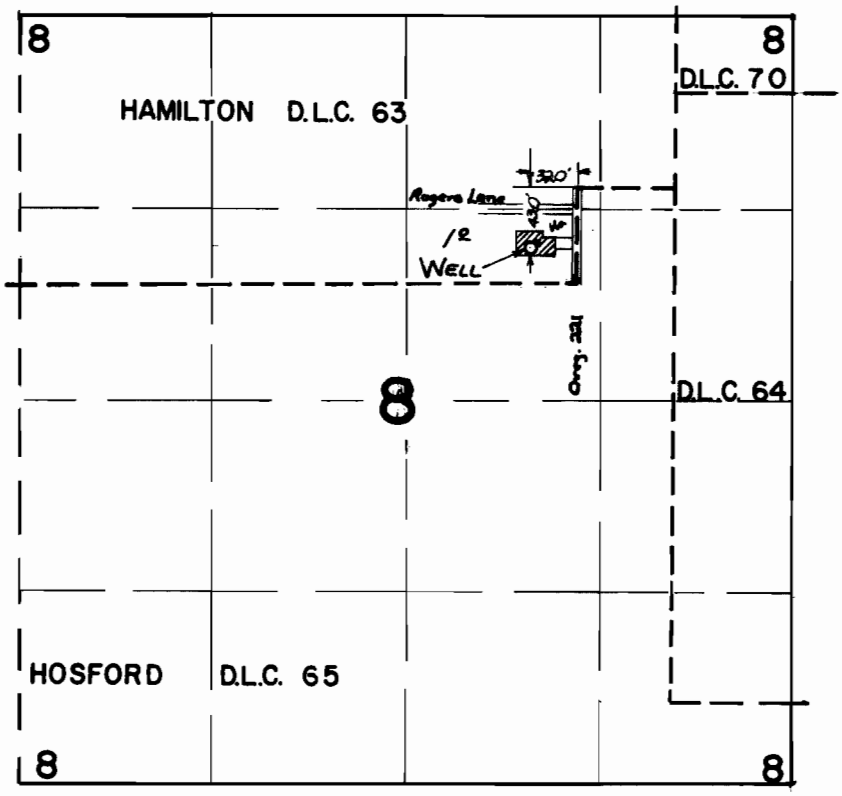

FINAL PROOF SURVEY
UNDER

Application No. G 2692 Permit No. G 2497
IN NAME OF

FRANCIS L. WALLER

Surveyed 4 SEPT 1969, by D. R. BUELL

Ch. Survey