


# T. 7 S. R. 5 W. W. M.

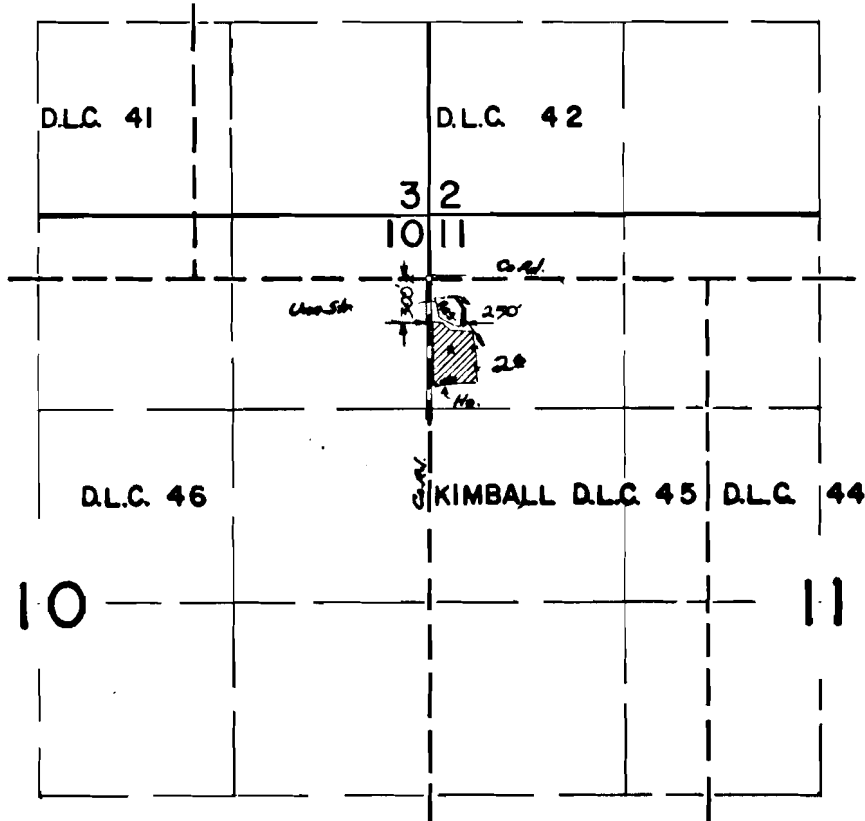

## FINAL PROOF SURVEY UNDER

R39317                      R 3898  
 Application No. 39318      Permit No. 29280  
 IN NAME OF

JOHN P. FRIESEN

Surveyed 2 JULY 1969, by D.R. BUELL