


T. 7 S. R. 4 & 5 W. W.M.

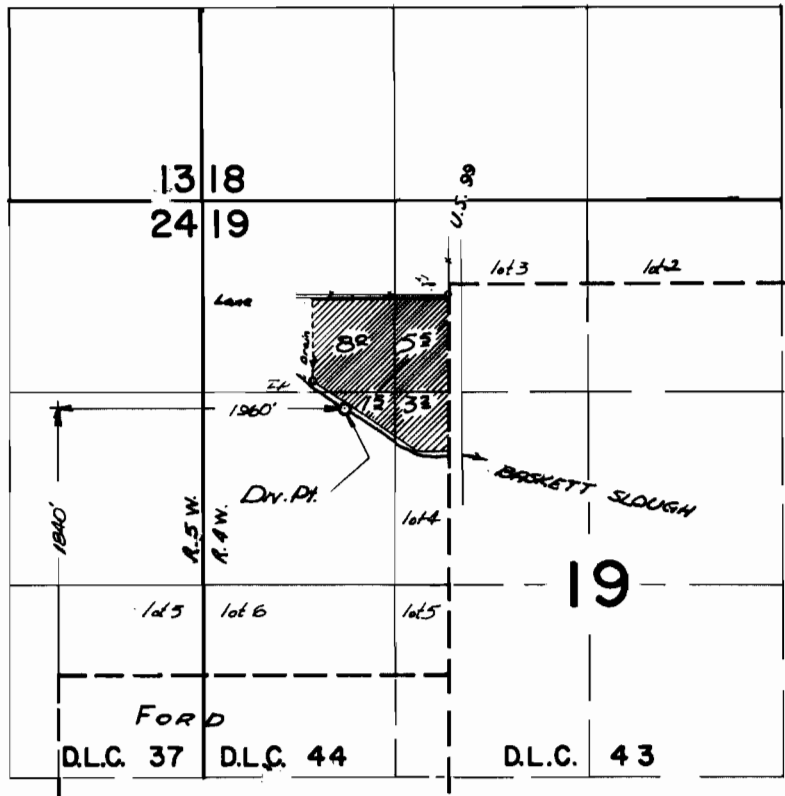

FINAL PROOF SURVEY
UNDER

Application No. 39120..... Permit No. 29120.....
IN NAME OF

.....**HERBERT L. LANGE**.....

Surveyed 2 JULY... 1969, by D. R. BUELL.....