


T.7S.R.4W. W.M.

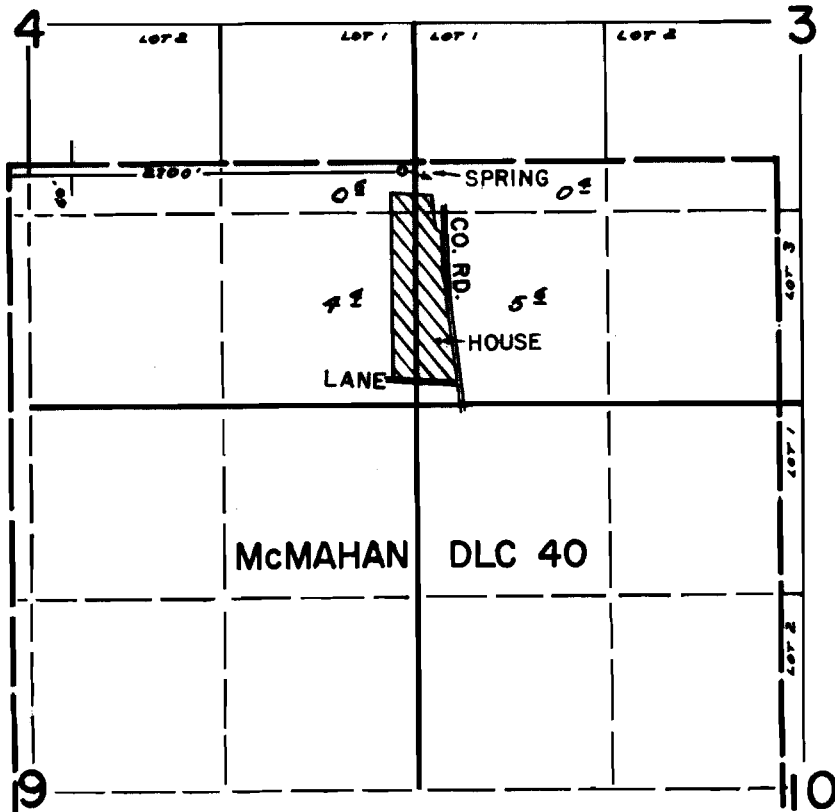

FINAL PROOF SURVEY
UNDER

Application No. 40830..... Permit No. 30418.....
IN NAME OF

.....**STAN KLIMCZAK**.....

Surveyed JUNE 30 1969., by D.R. BUELL.....