


T. 7 S. R. 5 W. W.M.

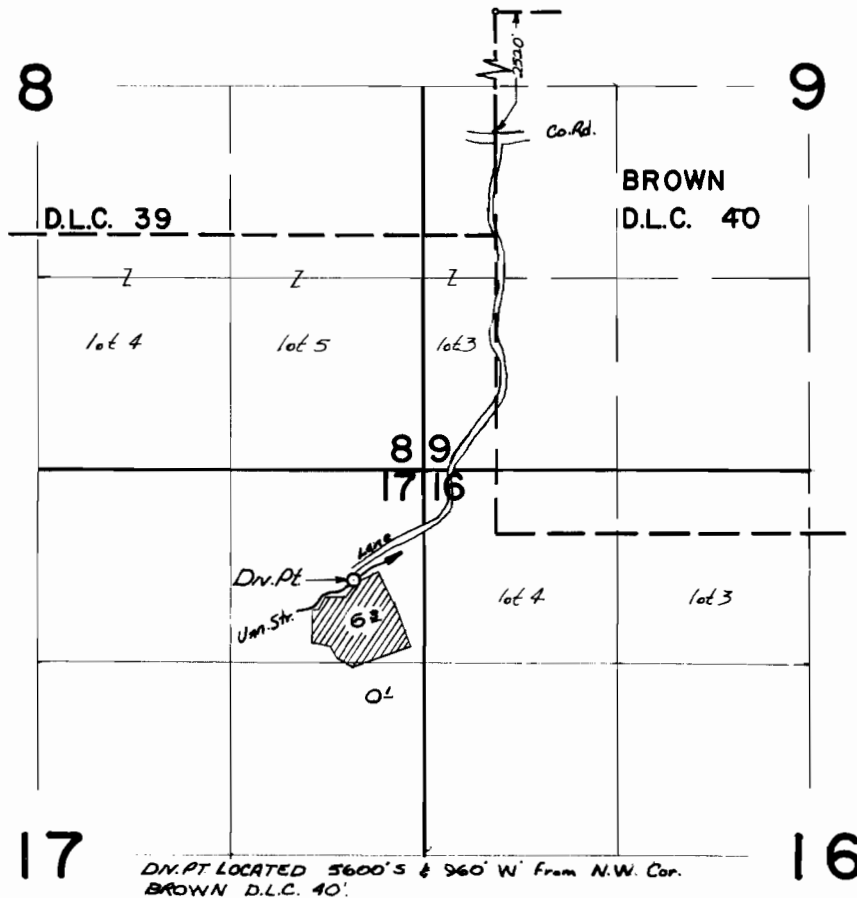

FINAL PROOF SURVEY
UNDER

Application No. 41654 Permit No. 31084
IN NAME OF

PAUL REIMER

Surveyed 1 JULY 1969, by D. R. BUELL