


# T.9S.R.5 W.W.M.

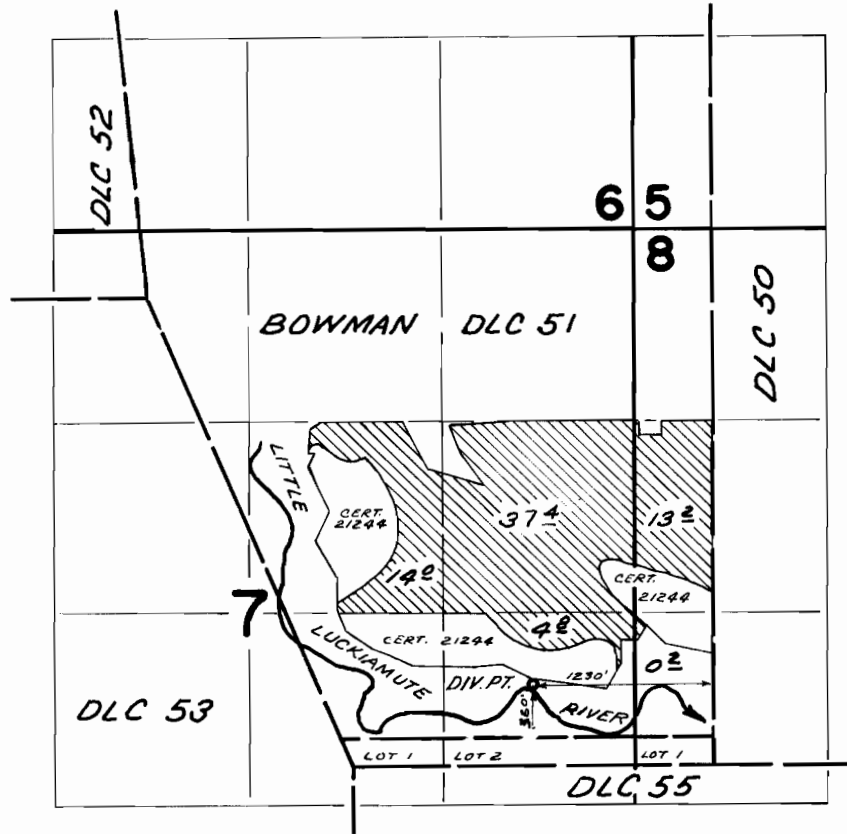

## FINAL PROOF SURVEY UNDER

Application No. 42583 Permit No. 31818  
IN NAME OF

LOWELL KAUP

Surveyed APR. 3 1969, by D. BUELL